

KANSAS

FORM 51 5M 4-41 PETROL

Phillips


Section 26 Township 2 Range 19-W

Well No. #1 Schulz

Company Carter

Dayton Pool

NORTH

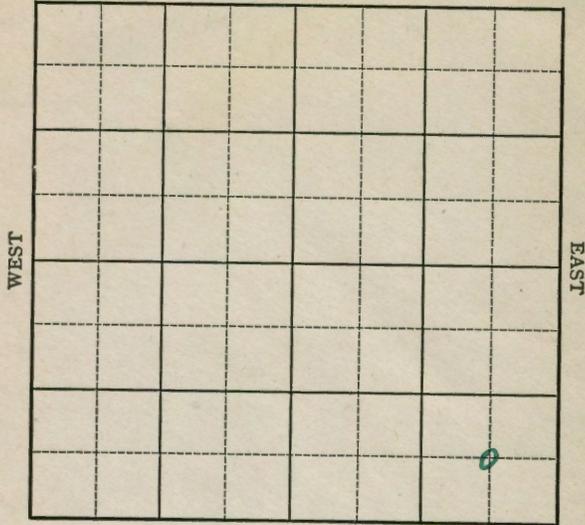

SOUTH

16

FORM 252 A
5M 10-41 PETROL

KANSAS

Phillips

Sec. 26 Twp. 2 R. 19-W

Well No. #1 Schulz Farm _____


Carter Company _____
(Dayton)

_____ Ft. from N. Line

660 Ft. from S. Line

660 Ft. from E. Line

_____ Ft. from W. Line

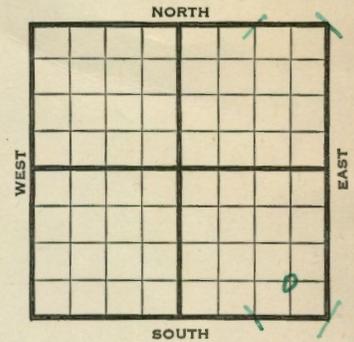

Elev. 2150

1942	REPORT
6/17	Location
6/24	8" - 288' Drlg. 2005'
7/1	Anhy. 1613' Topeka 3012' Lans. 3233' T.D. 3430' Run 5".
7/8	5" - 3421' 500 acid at 3421-30' no shows. Ripped csg. 3402-12' 500 acid. Ripped csg. 3377-91' 500 XXXX acid. Testing.
7/14	Swab 9 oil per hour.
7/22	Swab 9 oil per hour.
7/29	" " "
8/5	5" - 3421' Lans. 3233' Perf. Lansing 5000 acid. T.D. 3430' Pump 132 Pot. Gravity 35. COMPLETED

Phillips **KANSAS**

Map No. 138 Sec. 26 Twp. 2 R. 19W

Well No. 1 Schulz

Carter Company

COMPLETED Contractor

C S E S E

SECTION PLAT

			o

_____ Ft. from N. Line

660 Ft. from S. Line

660 Ft. from E. Line

_____ Ft. from W. Line

DAYTON POOL

Location _____

Rig up _____

Drilling and Remarks:

Lans 3233
5' @ 342'
Per. Lansing
5000 cu. ft.
Pump 132 P.D.
35' @ 4'

RECORD

Cased _____ in., _____ ft.

Sand _____

Gas _____

Oil _____

Total Depth 3430

PRODUCTION

1st 24 hrs. Nat. _____

1st 24 hrs. after shot _____

Gas _____ Cu. Ft.

Dry Hole _____

Abandoned _____

Date _____

AUG 5 1942

S. J. LEWIS Scout

Phillips **KANSAS**

Map No. 138 Sec. 26 Twp. 2 R. 19W

Well No. 1 Schulz

CARTER Company

FIRST REPORT Contractor

C S E S E

SECTION PLAT

			o

_____ Ft. from N. Line

660 Ft. from S. Line

660 Ft. from E. Line

_____ Ft. from W. Line

DAYTON POOL

Location XXX

Rig up _____

Drilling and Remarks:


RECORD

Cased _____ in., _____ ft.

Sand _____

Gas _____

Oil _____

Total Depth _____

PRODUCTION

1st 24 hrs. Nat. _____

1st 24 hrs. after shot _____

Gas _____ Cu. Ft.

Dry Hole _____

Abandoned _____

Date _____

JUN 17 1942

S. J. LEWIS Scout