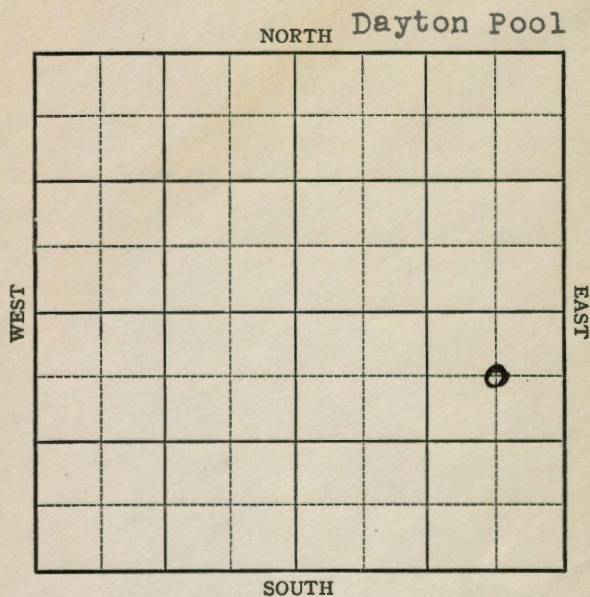


KANSAS

Phillips

FORM 51 5M 10-41 PETROL

Section 26 Township ~~2~~ 2 Range 19-WWell No. #2 Anna SchulzCompany CarterForm 252-A
5M 5-42 Petrol

KANSAS


Phillips

Sec. 26 Twp. 2 R. 19-WWell No. #2 Anna Schulz FarmCarter Company

(Dayton Pool)

660 Ft. from N. Line Ft. from S. Line660 Ft. from E. Line Ft. from W. Line

Elev. 2132

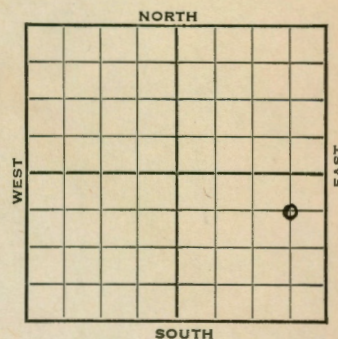

1942

REPORT

7/22

Drlg. 145'

7/29

8" - 274'

Drlg. 2740'

8/5

Lans. 3217 SO 3218 to 3409

5" - 3412

T.D. 3413 RUST

8/12

TD 3413

Ripped csg. 3364-73

10 Gals water per hr.

8/19

Ripped csg, 3406-12, 3392-98, 3345-50
 3330-38, 3307-11, 3388-93, 3270-76,
 3220-24 - 6000 acid swab 12 oil per
 hr - 2 hours.

8/27

Pump 111 in 23 hrs.

9/2

" " "

9/9

Lans. 3217 5" - 3412

Ripped csg - 6000 acid

Pump 150 oil & 100 water Pot.

T.D. 3413

Gravity 35.8.

COMPLETED

Phillips KANSAS

Map No. 138 Sec. 26 Twp. 2 R. 19WWell No. 2 Anna Schulz

Carter

Company

FIRST REPORT

Contractor

C NE SE

SECTION PLAT

660 Ft. from N. Line

Ft. from S. Line

660 Ft. from E. Line

Ft. from W. Line

DAYTON POOL

Location

RECORD

Cased in, ft.

Sand

Gas

Oil

Total Depth

Rig up

Drilling and Remarks:

Drlg. 145'

PRODUCTION

1st 24 hrs. Nat.

1st 24 hrs. after shot

Gas Cu. Ft.

Dry Hole

Abandoned

Date

JUL 22 1942 19

S. J. LEWIS Scout

Phillips KANSAS

Map No. 138 Sec. 26 Twp. 2 R. 19WWell No. 2 Anna Schulz

Carter

Company

COMPLETED

Contractor

C NE SE

SECTION PLAT

660 Ft. from N. Line

Ft. from S. Line

660 Ft. from E. Line

Ft. from W. Line

DAYTON POOL

Location

RECORD

Cased in, ft.

Sand

Gas

Oil

Total Depth 3413

Rig up

Drilling and Remarks:







PRODUCTION

1st 24 hrs. Nat.

1st 24 hrs. after shot

Gas Cu. Ft.

Dry Hole

Abandoned

Date

SEP 9 1942 19

S. J. LEWIS Scout