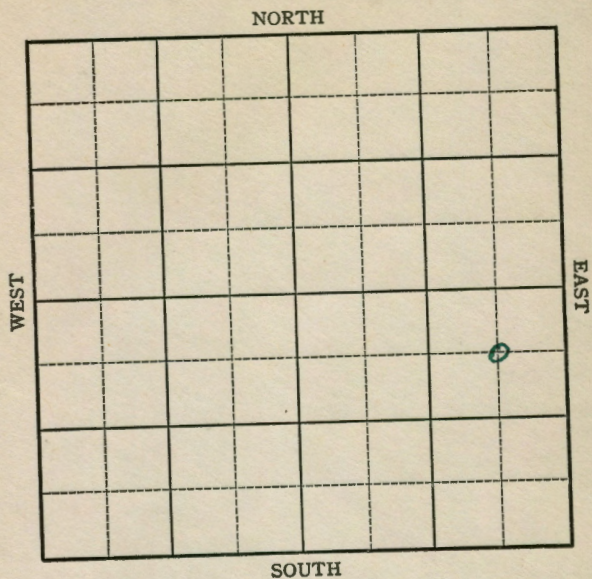


KANSAS

Phillips

Section 35 Township 2 Range 19-WWell No. #1 DusinCompany Carter Oil

9

KANSAS

Phillips

Sec. 35 Twp. 2 R. 19-WWell No. #1 Dusin Farm _____Carter Oil Company _____

(Dayton)


660 Ft. from N. Line

Ft. from S. Line

660 Ft. from E. Line

Ft. from W. Line

Elev. 2078

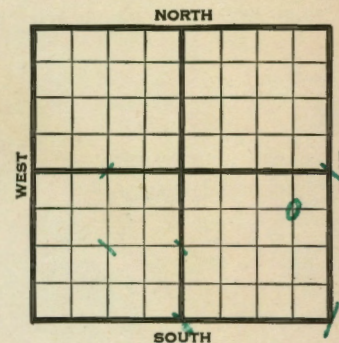

1941	REPORT
11/25	Location
12/4	8" - 252' Drlg. 2773'
12/11	Lans. 3148' S.O. 3148-53, 3177-3201, 3217-25, 3261-63, 3315-21, 3332-38' T.D. 3344' 5" - 3332' RUST.
12/18	Ripped csg. 3192 to 3261 17000 acid swb. 5l oil per hr. 2 hrs.
12/24	" " "
12/31	" " "
1942	
1/7	Lans. 3148' 5" - 3332' T.D. 3344' Ripped csg. 3148-3322' 17,000 acid. Echometer potential 1673 bbls. 34.7 Gravity
	COMPLETED

Phillips

KANSAS

Map No. 138 Sec. 35 Twp. 2 R. 19WWell No. 1 Dusin

Carter Oil

Company

COMPLETED

Contractor

C NE SE


660 Ft. from N. Line

Ft. from S. Line

660 Ft. from E. Line

Ft. from W. Line

SECTION PLAT

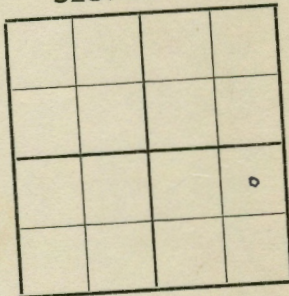

DAYTON POOL

Location

Rig up

Drilling and Remarks:

*Lease 3148**5 3332**Ref. sol. aug 3148-3322**19000 Cu. Ft.**Echo PT. 1673**342 Gr*

RECORD

Cased in, ft.

Sand

Gas

Oil

Total Depth *3344*

PRODUCTION

1st 24 hrs. Nat.

1st 24 hrs. after shot

Gas Cu. Ft.

Dry Hole

Abandoned

Date

JAN 7 1942 19

S. J. LEWIS

Scout

Phillips

KANSAS

Map No. 1-138 Sec. 35 Twp. 2 R. 19WWell No. 1 Dusin

Carter Oil

Company

FIRST REPORT

Contractor

C NE SE


660 Ft. from N. Line

Ft. from S. Line

660 Ft. from E. Line

Ft. from W. Line

SECTION PLAT

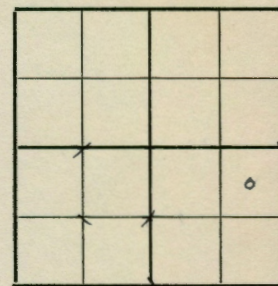

DAYTON POOL

Location XX

Rig up

Drilling and Remarks:

RECORD

Cased in, ft.

Sand

Gas

Oil

Total Depth

PRODUCTION

1st 24 hrs. Nat.

1st 24 hrs. after shot

Gas Cu. Ft.

Dry Hole

Abandoned

Date

NOV 25 1941 19

S. J. LEWIS

Scout