


Section 35 Township 2 Range 19-W

Well No. #2 Dusin #1

Company Carter Oil

NORTH Dayton Pool

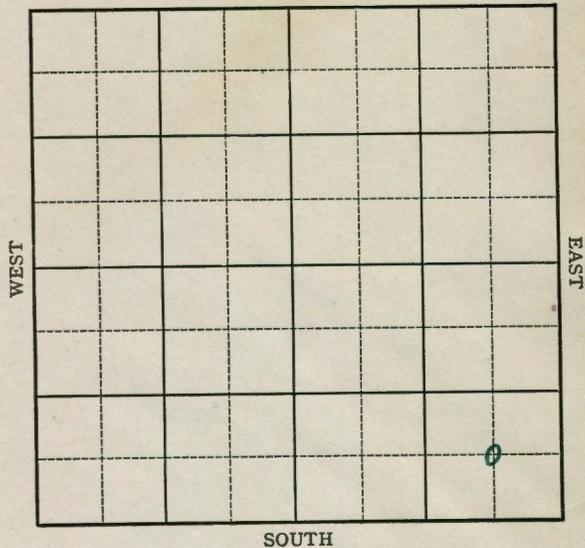

16

Sec 35 Twp. 2 R. 19-W

Well No. #2 Dusin #1 Flossie Dusin Farm

Carter Oil Company

(Dayton)


_____ Ft. from N. Line

660 Ft. from S. Line

660 Ft. from E. Line

_____ Ft. from W. Line

Elev. 2039

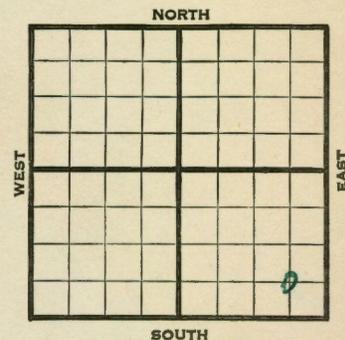

1942	REPORT
2/18	Location
2/26	8" - 272' Drlg. 1005'
3/5	Lans. 3113' SSO 3113-16, 3130-33, 3176-80, 3182-85, 3210-13' Drlg. 3215'
3/11	S.O. 3226-28, 3282-86, 3299-3301. T.D. 3311' 5" - 3300' RUST.
3/19	Ripped csg. 3113-3294' 9000 acid. Swab 23 oil in 3 hours.
3/25	Lans. 3113' 5" - 3300' T.D. 3311' Ripped casing 3113-3294' 10,000 acid. Potential 272 bbls., pump. 36. Gravity
	COMPLETED

KANSAS

Phillips

Map No. 138 Sec. 35 Twp. 2 R. 19W

Well No. 1 Flossie

Carter Oil Company

COMPLETED

Contractor

C S E S E

SECTION PLAT

_____ Ft. from N. Line

630 Ft. from S. Line

660 Ft. from E. Line

_____ Ft. from W. Line

DAYTON POOL

Location _____

RECORD

Cased _____ in., _____ ft.

Sand _____

Gas _____

Oil _____

Total Depth 3311

Rig up _____

Drilling and Remarks:

Lane 3113

5" 3300

Applying 3113-3294

10000 acid

Pump 252 Port

360 yd

PRODUCTION

1st 24 hrs. Nat. _____

1st 24 hrs. after shot _____

Gas _____ Cu. Ft.

Dry Hole _____

Abandoned _____

Date

MAR 25 1942 19

S. J. LEWIS Scout

KANSAS

Phillips

Map No. 138 Sec. 35 Twp. 2 R. 19W

Well No. 2 Dusin

Carter Oil Company

FIRST REPORT

Contractor

C S E S E

SECTION PLAT

_____ Ft. from N. Line

660 Ft. from S. Line

660 Ft. from E. Line

_____ Ft. from W. Line

DAYTON POOL

Location XXX

RECORD

Cased _____ in., _____ ft.

Sand _____

Gas _____

Oil _____

Total Depth _____

Rig up _____

Drilling and Remarks:

PRODUCTION

1st 24 hrs. Nat. _____

1st 24 hrs. after shot _____

Gas _____ Cu. Ft.

Dry Hole _____

Abandoned _____

Date

FEB 18 1942 19

S. J. LEWIS Scout

Phillips **KANSAS**

Map No. 138 Sec. 35 Twp. 2 R. 19W

Well No. 1 Flossie Dusin

Carter Oil Company

CORRECTION Contractor

C SE SE


SECTION PLAT

_____ Ft. from N. Line

660 Ft. from S. Line

660 Ft. from E. Line

_____ Ft. from W. Line

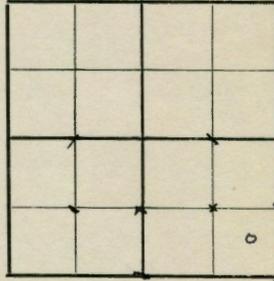

DAYTON POOL

Location _____

Rig up _____

Drilling and Remarks:
Reported as

#2 Dusin

RECORD

Cased _____ in., _____ ft.

Sand _____

Gas _____

Oil _____

Total Depth _____

PRODUCTION

1st 24 hrs. Nat. _____

1st 24 hrs. after shot _____

Gas _____ Cu. Ft.

Dry Hole _____

Abandoned _____

Date

FEB 25 1942 19

S. J. LEWIS Scout

Map No. 19 Sec. 35 Twp. S R. 19W

Well No. 1 Piosale Drain

Please check range. We show 19-W.

Contractor

C. S. Paul

SECTION PLAT

ft. from N. line

680 ft. from S. line

680 ft. from E. line

ft. from W. line

DAYTON POOL

RECORD

Cased in _____ ft.

Sand _____

Gas _____

Oil _____

Location _____

Rig up _____

Drilling and Remarks: _____

Reported as _____

#2 Drain

- Misc Small Maps _____
- Cards _____
- Tracing _____
- France Map _____
- Searborough Map _____
- Moody Map _____
- Geological Dept. _____
- Moody Map Book _____

Date _____

FEB 2 5 1942