


Section 35 Township 2 Range 19-W

Well No. #3 Dusin

Company Carter

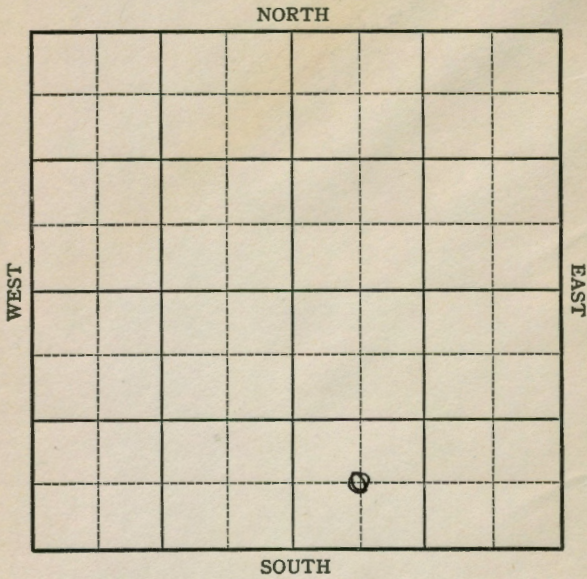

15

Sec. 35 Twp. 2 R. 19-W

Well No. #3 Dusin Farr

Carter Compan

(Dayton)


_____ Ft. from N. Line

660 Ft. from S. Line

_____ Ft. from E. Line

660 Ft. from W. Line

Elv. 2073

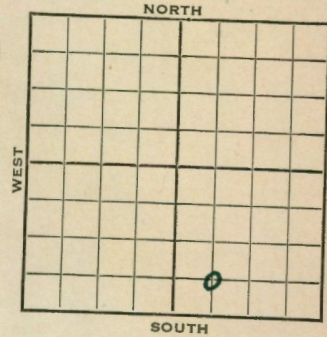

REPORT	
1942	
7/15	Drlg. 200'
7/22	8" - 303' Lans. 3167' S.O. 3167-71' Drlg. 3174'
7/29	T.D. 3360 5" - 3357' RUST
8/5	"
8/12	Ripped csg. 3353-55
8/19	Fsg.
8/27	"
9/2	"
9/9	Plug 3300 Ripped csg 3165-75, 3182-86, 3216-20 Testing
9/16	Ripped csg 3274-78, 3252-55 3235-39 swb 3 bbls water per hr
9/23	Lans. 3167 5" 3357 T.D. 3360 Ripped csg. 6000 acid Water
	ABANDONED

KANSAS

Phillips

Map No. 138 Sec. 35 Twp. 2 R. 19W

Well No. 3 Dusin

Carter Company

ABANDONED Contractor

C SW SE

SECTION PLAT

_____ Ft. from N. Line

660 Ft. from S. Line

_____ Ft. from E. Line

660 Ft. from W. Line

DAYTON POOL

Location _____

Rig up _____

Drilling and Remarks:

*Loss 3/67
5" @ 3357
Ripped casing.
6000 acid
Water*

RECORD

Cased _____ in., _____ ft.

Sand _____

Gas _____

Oil _____

Total Depth 3360

PRODUCTION

1st 24 hrs. Nat. _____

1st 24 hrs. after shot _____

Gas _____ Cu. Ft.

Dry Hole _____

Abandoned _____

Date

SEP 23 1942 19

S. J. LEWIS Scout

KANSAS

Phillips

Map No. 138 Sec. 35 Twp. 2 R. 19W

Well No. 3 Dusin

Carter Company

FIRST REPORT Contractor

C SW SE

SECTION PLAT

_____ Ft. from N. Line

660 Ft. from S. Line

_____ Ft. from E. Line

660 Ft. from W. Line

DAYTON POOL

Location _____

Rig up _____

Drilling and Remarks:

Drig. 200'

RECORD

Cased _____ in., _____ ft.

Sand _____

Gas _____

Oil _____

Total Depth _____

PRODUCTION

1st 24 hrs. Nat. _____

1st 24 hrs. after shot _____

Gas _____ Cu. Ft.

Dry Hole _____

Abandoned _____

Date

JUL 15 1942 19

S. J. LEWIS Scout