


KANSAS

FORM 51 5M 10-41 PETROL

Phillips

Section 35 Township 2 Range 19-W
 Well No. #4 C. G. Eltiste
 Company Carter Oil

NORTH Dayton Pool

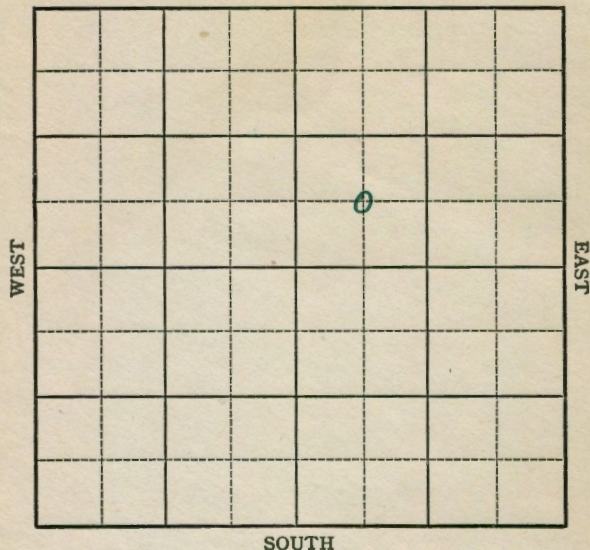

SOUTH

7

Form 252-A
5M 5-42 Petrol

KANSAS

Phillips

Sec. 35 Twp. 2 R. 19-W
 Well No. #4 C. G. Eltiste Farm
Carter Oil Company
 (Dayton)


Ft. from N. Line

660 Ft. from S. Line

Ft. from E. Line

660 Ft. from W. Line

Elev. 2060

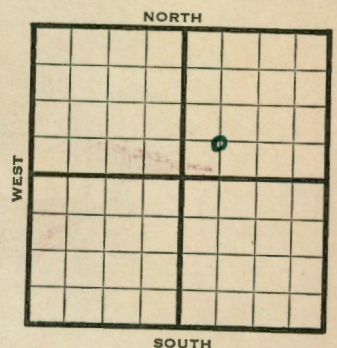

1942

REPORT

7/1

Location

7/8

8" - 284' Drlg. 2970'

7/15

Lans. 3155' S.O. 3155-58, 3165-68,
 3203-06, 3207-12, 3214-17, 3222-27,
 3243-48' T.D. 3350' 5" - 3347'
 RUST.

7/22

Rip csg. 3318-42' Swab 1 bbl. fluid
 per hour, 75% water.

7/29

" " " "

8/5

P.B. 3304
 Rip csg 3293-3301 - 500 acid
 water - P.B. 3270
 Rip Csg. 3152-3266 - 1000 acid

8/12

" " " " "

8/19

" " " " "

8/27

Lans. 3155 5" - 3347
 Perf. Lans. 8500 acid
 Pump 63 oil & 20 water
 T.D. 3350
 Gravity 35.8

COMPLETED

KANSAS

Phillips

Map No. 138 Sec. 35 Twp. 2 R. 19WWell No. 4 C. G. Eltiste

Carter Oil

Company

COMPLETED

Contractor

C S W N E

SECTION PLAT

Ft. from N. Line

660 Ft. from S. Line

Ft. from E. Line

660 Ft. from W. Line

DAYTON POOL

Location

RECORD

Cased in., ft.

Sand

Gas

Oil

Total Depth 8350

PRODUCTION

1st 24 hrs. Nat.

1st 24 hrs. after shot

Gas Cu. Ft.

Dry Hole

Abandoned

Rig up

Drilling and Remarks:

Lans 3/555" @ 3347Perf. Lans.7500 acidPump. 68 oil +20 Water35 E. G.

Date

AUG 27 1942 19S. J. LEWIS

Scout

KANSAS

Phillips

Map No. 138 Sec. 35 Twp. 2 R. 19WWell No. 4 C. G. Eltiste

Carter Oil

Company

FIRST REPORT

Contractor

C S W N E

SECTION PLAT

Ft. from N. Line

660 Ft. from S. Line

Ft. from E. Line

660 Ft. from W. Line

Dayton Pool

Location XXX

RECORD

Cased in., ft.

Sand

Gas

Oil

Total Depth

PRODUCTION

1st 24 hrs. Nat.

1st 24 hrs. after shot

Gas Cu. Ft.

Dry Hole

Abandoned

Rig up

Drilling and Remarks:

Date

JUL 1 1942 19S. J. LEWIS

Scout