

Section 36 Township 2 Range 19-W

Well No. #1 Friebus

Company H. L. Weirick et al

NORTH

Wildcat

WEST

EAST

SOUTH

5

Sec. 36 Twp. 2 R. 19-W

Well No. #1 Friebus Farm

Well No. Farm
Carter Oil et al
H. L. Weirick et al Company

(Wildcat)

_Ft. from N. Line

660 Ft. from S. Line

_Ft. from E. Line

330 Ft. from W. Line

Elev. 2103

NORTH

Abstract

EAST

SOUTH

194

REPORT

5/27

Derri ck.

6/5

12" - 225' Anhy 1560'

Dr1g. 2208'

6/12

Topeka 2925' Lans. 3169'

S.S.O. 3169-74, 3257-60, 3272-81

3334-38 & 3355-57

Marmation 3413' Drlg. 3466'

6/19

Arb. 3535! Granite wash 3815!

Granite 38 61' T.D. 5" - 3445'

RUST.

6/25


1

7/3

2000 acid. 14 bbls. oil 3254-
Ripped 5" - 3245-50'

OVER

Section 36 Township 2 Range 19-W
Well No. #1 Friebus
Carter Oil et al
Company H. L. Weirick et al

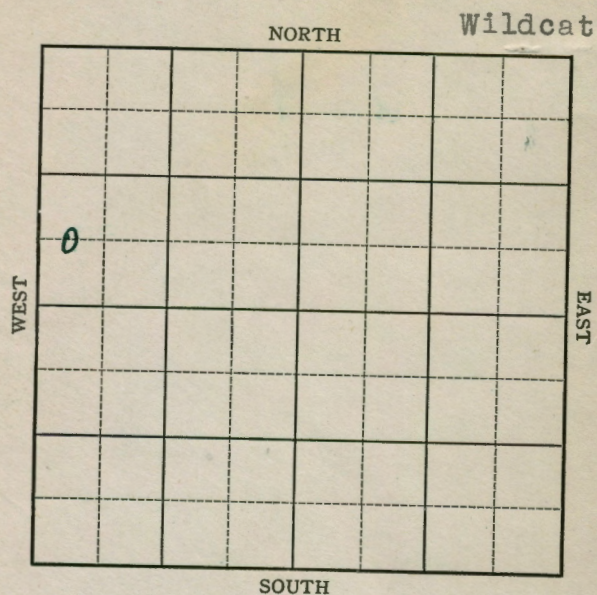

EAST

5

Sec. 36 Twp. 2 R. 19-W
Well No. #1 Friebus Farm
Carter Oil et al
H. L. Weirick et al Company

(Wildcat)


_____ Ft. from N. Line

660 Ft. from S. Line

Ft. from E. Line

330 Ft. from W. Line

Elev. 2103

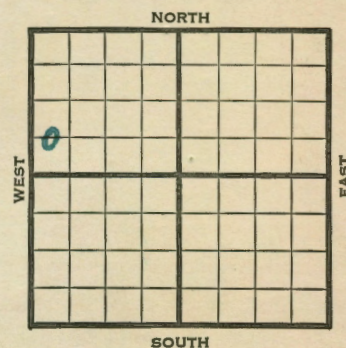[illegible]

1941
7/9

Lans. 3169'

Arb. 3535'

5" - 3312'

T.D. 3861'

Ripped 5" - 3245-50'

Potential 828 bbls., pump.

Granite 3861'

35.8 Gravity

COMPLETED

Map No. 138 Sec. 36 Twp. 2 R. 19WWell No. 1 FriebusH. L. Weirick etal

Company

FIRST REPORT

Contractor

C W L SW NW

SECTION PLAT

Ft. from N. Line

660 Ft. from S. Line

Ft. from E. Line

330 Ft. from W. Line

WILDCAT

0			

Location

RECORD

Rig up

Drilling and Remarks:

Derrick

Cased in. ft.

Sand

Gas

Oil

Total Depth

PRODUCTION

1st 24 hrs. Nat.

1st 24 hrs. after shot

Gas Cu. Ft.

Dry Hole

Abandoned

Date

MAY 27 1941 19S. J. LEWIS Scout

KANSAS

Map No. _____ Sec. 36 Twp. 2 R. 19W

Well No. 1 Friebus

Carter Oil et al Company

CORRECTION Contractor

C W L SW NW

SECTION PLAT

Ft. from N. Line

660 Ft. from S. Line

Ft. from E. Line

330 Ft. from W. Line

WILDCAT

Location _____

RECORD

Cased _____ in., _____ ft.

Sand _____

Gas _____

Oil _____

Total Depth _____

Rig up _____

Drilling and Remarks:

Was

H.L. Weirick et al

PRODUCTION

1st 24 hrs. Nat. _____

1st 24 hrs. after shot _____

Gas _____ Cu. Ft.

Dry Hole _____

Abandoned _____

Date

JUL 9 1941 19 S. J. LEWIS Scout

KANSAS

Map No. 138 Sec. 36 Twp. 2 R. 19W

Well No. 1 Friebus

Carter Oil et al Company

Contractor

COMPLETED

SECTION PLAT

C W L SW NW

Ft. from N. Line

660 Ft. from S. Line

Ft. from E. Line

330 Ft. from W. Line

WILDCAT

Location _____

RECORD

Cased _____ in., _____ ft.

Sand _____

Gas _____

Oil _____

Total Depth 3861

Rig up _____

Drilling and Remarks:

Lance 3169

Cu x 3035

5" @ 3312

Rigged 5' @ 3245-50

Pump 325 R x

Granite 3861

358 Gr

PRODUCTION

1st 24 hrs. Nat. _____

1st 24 hrs. after shot _____

Gas _____ Cu. Ft.

Dry Hole _____

Abandoned _____

Date

JUL 9 1941 19 S. J. LEWIS Scout