

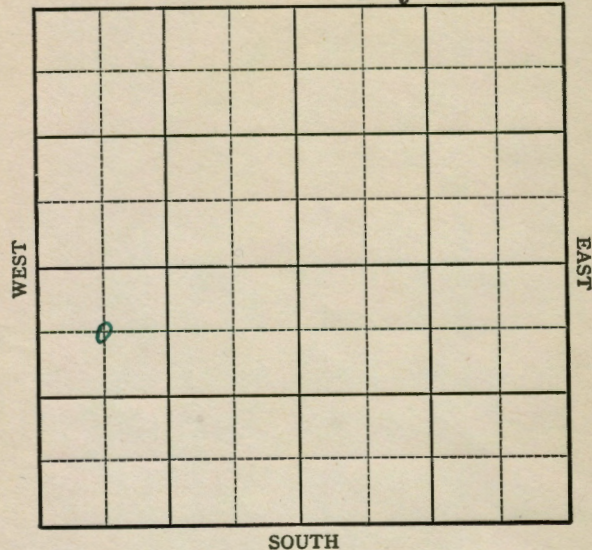
KANSAS

Phillips

FORM 51 5M 10-41 PETROL

Section 36 Township 2 Range 19-WWell No. 1 GarberCompany Carter

NORTH Dayton Pool



SOUTH

EAST

12

FORM 252-A
5M 10-41 PETROL

KANSAS

Phillips

Sec. 36 Twp. 2 R. 19-WWell No. #1 Garber Farm _____

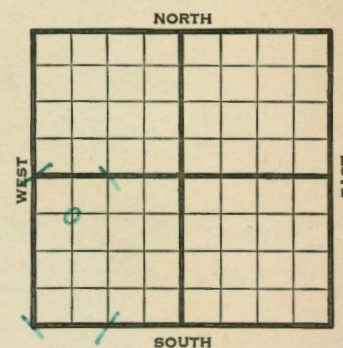
Carter Company _____

(Dayton)

660 Ft. from N. Line

_____ Ft. from S. Line

_____ Ft. from E. Line

660 Ft. from W. LineElev. 2068

1941	REPORT
12/30	Location
1942	
1/8	8" - 276' Drlg. 1499'
1/15	Topeka 2905' Lans. 3128' S.S.O. Drlg. 3134'
1/22	S.S.O. all way way from 3128 to 3317' T.D. 3323' Run csg.
1/29	5" - 3311' Ripped csg. 3127 to 3303' 2000 acid. Swab 60 oil in 1 hour.
2/4	Lans. 3128' 5" - 3311' T.D. 3323' Ripped casing 3127-3303' 2000 acid. Echometer potential 2064 bbls. 35. Gravity
	COMPLETED

Phillips **KANSAS**Map No. 13P Sec. 36 Twp. 2 R. 19WWell No. 1 GarberCarter

Company

COMPLETED

Contractor

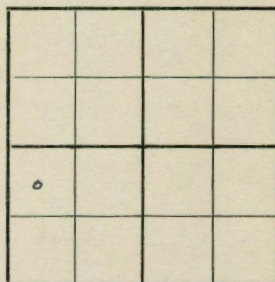
C NW SW

SECTION PLAT

660 Ft. from N. Line

Ft. from S. Line

Ft. from E. Line

660 Ft. from W. Line

DAYTON POOL

Location

Rig up

Drilling and Remarks:

Logging 8/28
5" O 8311
Refracting 8/27-3303
2000 Acid
Echo Pad 2064
35-2 Gr

RECORD

Cased in. ft.

Sand

Gas

Oil

Total Depth 3323

PRODUCTION

1st 24 hrs. Nat.

1st 24 hrs. after shot

Gas Cu. Ft.

Dry Hole

Abandoned

Date

FEB 4 1942S. J. LEWIS ScoutPhillips **KANSAS**Map No. 13P Sec. 36 Twp. 2 R. 19WWell No. 1 GarberCarter

Company

FIRST REPORT

Contractor

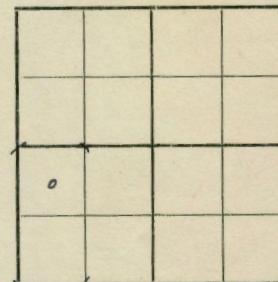
C NW SW

SECTION PLAT

660 Ft. from N. Line

Ft. from S. Line

Ft. from E. Line

660 Ft. from W. Line

DAYTON POOL

Location XX

Rig up

Drilling and Remarks:

RECORD

Cased in. ft.

Sand

Gas

Oil

Total Depth

PRODUCTION

1st 24 hrs. Nat.

1st 24 hrs. after shot

Gas Cu. Ft.

Dry Hole

Abandoned

Date

DEC 30 1941S. J. LEWIS Scout