


KANSAS

Phillips

FORM 51 5M 10-41 PETROL

Section 36 Township 2 Range 19-WWell No. #2 GarberCompany Carter Oil

NORTH Dayton Pool

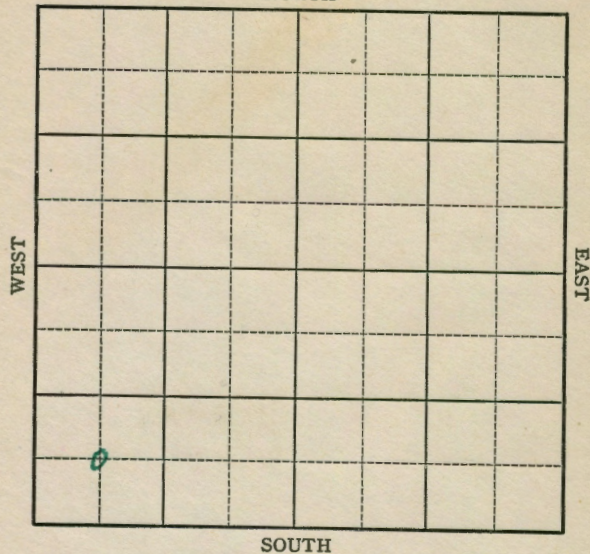

SOUTH

13

FORM 252-A
5M 10-41 PETROL

KANSAS

Phillips

Sec. 36 Twp. 2 R. 19-WWell No. #2 Garber FarmCarter Oil Company

(Dayton)


Ft. from N. Line

660 Ft. from S. Line

Ft. from E. Line

660 Ft. from W. Line

Elev. 2076

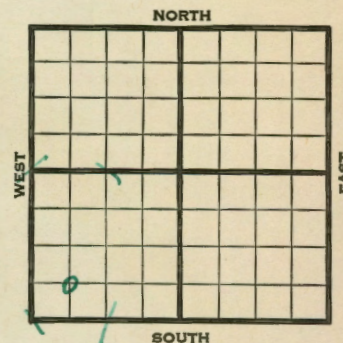

1942

REPORT

3/18

Location

3/26

8" - 274' Drlg. 2437'

4/2

Topeka 2918' Lans. 3144'

T.D. 3348' 5" - 3333' RUET.

4/8

Drilled cement to 3330'

Ripped casing 3143 to 3320' 1000 acid

Swab 149 oil in 4 hours.

37. Gravity

4/15

" "

4/22

Lans. 3144'

5" - 3333'

T.D. 3348'

Plug 3330'

Ripped casing 3143-3320'

10,000 acid.

Potential 778 bbls., pump.

37. Gravity

COMPLETED

Map No. 138 Sec. 36 Twp. 2 R. 19W

Well No. 2 Garber

Carter Oil Company

COMPLETED Contractor

C S W S W

Ft. from N. Line

660 Ft. from S. Line

Ft. from E. Line

660 Ft. from W. Line

SECTION PLAT

DAYTON POOL

Location

Rig up

Drilling and Remarks:

Lease 3144

5" C 3333

Plug 3330

Appraisal 3143-3330

10000' dical

Pump 778 P.Y.

37' G

RECORD

Cased in, ft.

Sand

Gas

Oil

Total Depth *3345*

PRODUCTION

1st 24 hrs. Nat.

1st 24 hrs. after shot

Gas Cu. Ft.

Dry Hole

Abandoned

Date

APR 22 1942 19

S. J. LEWIS

Scout

Map No. 138 Sec. 36 Twp. 2 R. 19W

Well No. 2 Garber

Carter Oil Company

FIRST REPORT Contractor

C S W S W

Ft. from N. Line

660 Ft. from S. Line

Ft. from E. Line

660 Ft. from W. Line

SECTION PLAT

DAYTON POOL

Location XXX

Rig up

Drilling and Remarks:

RECORD

Cased in, ft.

Sand

Gas

Oil

Total Depth

PRODUCTION

1st 24 hrs. Nat.

1st 24 hrs. after shot

Gas Cu. Ft.

Dry Hole

Abandoned

Date

MAR 18 1942 19

S. J. LEWIS Scout