


Section 35 Township 2 Range 19W
Well No. 1-Eltiste
Company Carter Oil

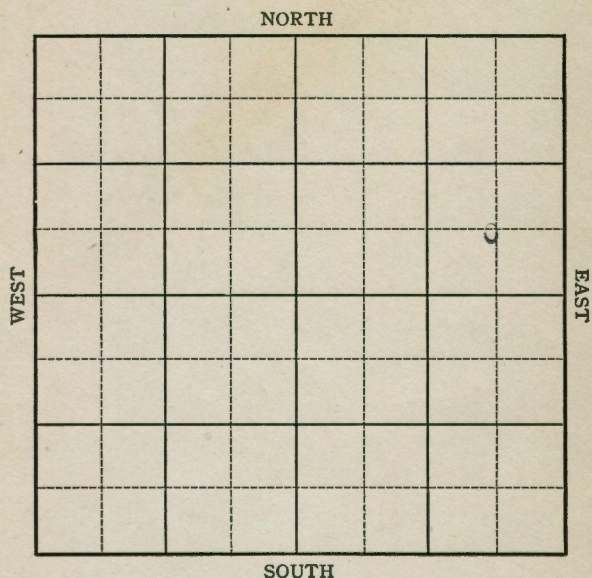

8

Sec. 35 Twp. 2 R. 19-W
Well No. #1 Eltiste Farm
Carter Oil Company

(Dayton)


_____ Ft. from N. Line

660 Ft. from S. Line

660 Ft. from E. Line

_____ Ft. from W. Line

Elw. 2085

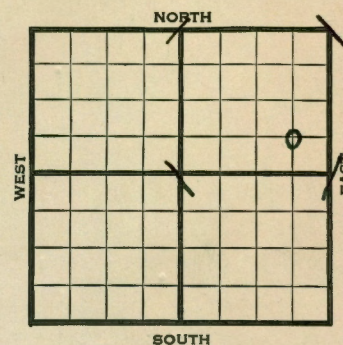[illegible]

1941

10/16 Ripped csg. 3211-22

" " 3231-38

" " 3250-53'

3000 acid. Swab 14 oil per hour

10/23 Pump 10 oil per hour 16 hours.

10/30 Pump 312 oil in 24 hours.

11/5 Lens. 3158'

Arb. 3525'

5" - 3410'

T.D. 3540'

P.B. to 3280'

Ripped csg. 3211-3253'

3000 acid.

Potential 42 bbls.

34.7 Gravity

COMPLETED


Map No. K-138 Sec. 35 Twp. 2 R. 19WWell No. 1 Eltiste

Carter Oil Company

COMPLETED Contractor

C SE NE

SECTION PLAT

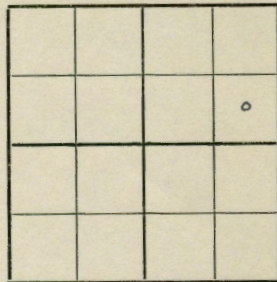

Ft. from N. Line

660 Ft. from S. Line660 Ft. from E. Line

Ft. from W. Line

DAYTON POOL

Location

Rig up

Drilling and Remarks:

*Line 3158**Cr 43525**5" @ 3410**PB 3280**App. col. aug. 3211 - 3253**3000 Seal**Pump 4260 Y**34241*

RECORD

Cased in, ft.

Sand

Gas

Oil

Total Depth 3570

PRODUCTION

1st 24 hrs. Nat.

1st 24 hrs. after shot

Gas Cu. Ft.

Dry Hole

Abandoned

Date

NOV 5 1941 19 S. J. LEWIS Scout

Map No. 138 Sec. 35 Twp. 2 R. 19WWell No. 1 Eltiste


Carter Oil Company

Contractor

FIRST REPORT

C SE NE

SECTION PLAT

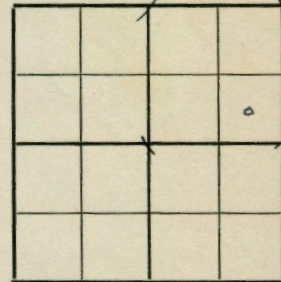

Ft. from N. Line

660 Ft. from S. Line660 Ft. from E. Line

Ft. from W. Line

Dayton Pool

Location

Rig up

Drilling and Remarks:

8" @ 259' W.O.C.

RECORD

Cased in, ft.

Sand

Gas

Oil

Total Depth

PRODUCTION

1st 24 hrs. Nat.

1st 24 hrs. after shot

Gas Cu. Ft.

Dry Hole

Abandoned

Date

SEP 10 1941 19 S. J. LEWIS Scout