

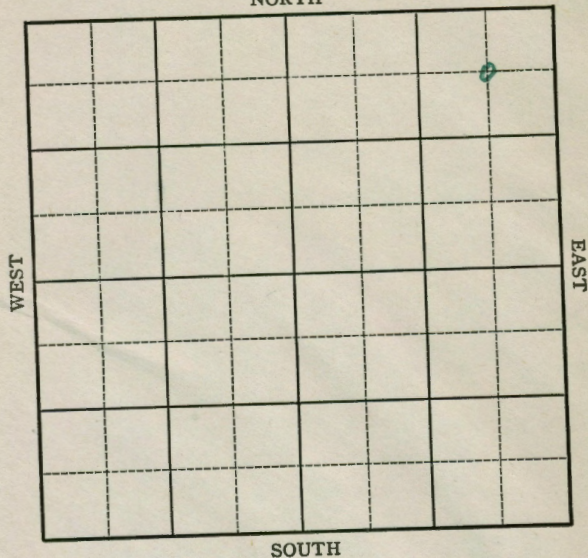
KANSAS

Phillips

FORM 51 5M 1-42 PETROL

Section 35 Township 2 Range 19-W
 Well No. #2 Eltiste
 Company Carter Oil

NORTH Dayton Pool

FORM 252-A
5M 10-41 PETROL

KANSAS

Phillips

Sec. 35 Twp. 2 R. 19-W

Well No. #2 Eltiste Farm
Carter Oil Company

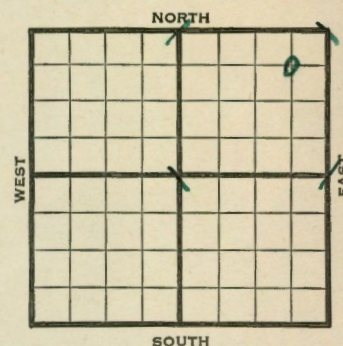
(Dayton)

660 Ft. from N. Line

Ft. from S. Line

660 Ft. from E. Line

Ft. from W. Line



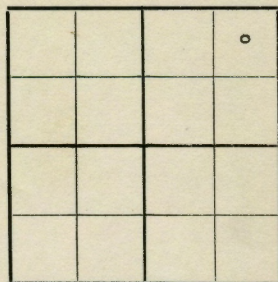
Elev. 2090

1942	REPORT
1/28	Location
2/5	Drlg. 2691'
2/12	8" - 261' Topeka 2951'
	Lans. 3171' S.S.O. 3176-77, 3191-93,
	3224-25, 3227-33, 3244-48, 3262-66,
	3266-71, 3342-43 $\frac{1}{2}$, 3345-63'
	T.D. 3368' 5" - 3357' RUST.
2/19	Ripped csg. 3343-48, 3256-58, 3219-30
	3186-91, 3168-74' 11,000 acid.
	Swab 25 oil & 150 water a day.
2/25	Lans. 3171'
	5" - 3357'
	T.D. 3368'
	Ripped casing. 11,000 acid.
	Pump 124 oil & 75 water.
	35.8 Gravity
	COMPLETED

Map No. 138 Sec. 35 Twp. 2 R. 19WWell No. 2 EltisteCarter Oil CompanyCOMPLETED Contractor

C NE NE

SECTION PLAT

660 Ft. from N. Line

Ft. from S. Line

660 Ft. from E. Line

Ft. from W. Line

DAYTON POOL

Location

Rig up

Drilling and Remarks:

Lease 81715" C 3357Applied 629.11000 acidPump 124 oil + 20355 G

RECORD

Cased in, ft.

Sand

Gas

Oil

Total Depth 8365

PRODUCTION

1st 24 hrs. Nat.

1st 24 hrs. after shot

Gas Cu. Ft.

Dry Hole

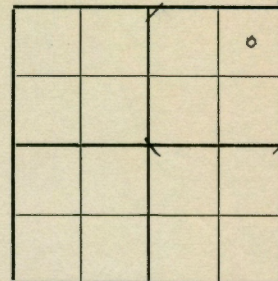
Abandoned

Date

FEB 25 1942 19S. J. LEWIS ScoutMap No. 138 Sec. 35 Twp. 2 R. 19WWell No. 2 EltisteCarter Oil CompanyFIRST REPORT Contractor

C NE NE

SECTION PLAT

660 Ft. from N. Line

Ft. from S. Line

660 Ft. from E. Line

Ft. from W. Line

DAYTON POOL

Location XX

Rig up

Drilling and Remarks:

RECORD

Cased in, ft.

Sand

Gas

Oil

Total Depth

PRODUCTION

1st 24 hrs. Nat.

1st 24 hrs. after shot

Gas Cu. Ft.

Dry Hole

Abandoned

Date

JAN 28 1942 19S. J. LEWIS Scout