


KANSAS

Phillips

FORM 51 5M 10-41 PETROL

Section 36 Township 2 Range 19-W
 Well No. #3 Eltiste
 Company Carter

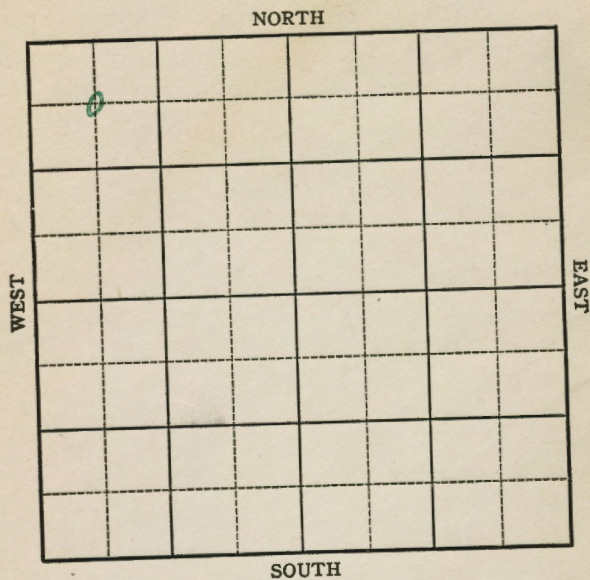

4

FORM 252-A
5M 10-41 PETROL


KANSAS

Phillips

Sec. 36 Twp. 2 R. 19-W
 Well No. #3 Eltiste Farm
 Carter Company

(Dayton)

660 Ft. from N. Line
 _____ Ft. from S. Line
 _____ Ft. from E. Line
660 Ft. from W. Line

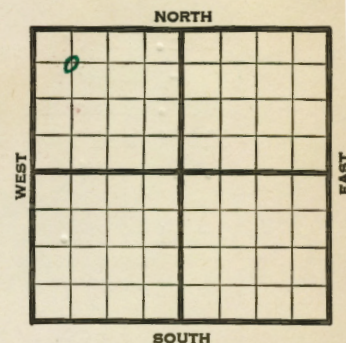

Elev. 2138

1942	REPORT
5/6	Location
5/13	"
5/20	"
5/27	"
6/3	8" - 278' WOC.
6/10	Drlg. 2750'
6/18	Topeka 2985' Lans. 3213'
	S.O. 3213-16, 3263-69, 3281-86, 3297-3300, 3308-09' T.D. 3407'
	Run 5".
6/24	5" - 3394' 1000 acid.
7/1	Ripped casing 3258-3386' 11,000 acid. Swab 16 oil per hour 5 hours.
7/8	Pump 14 oil per hour 2 hours.
7/15	" " " "
7/22	" " " "
7/29	" " " "
	OVER

561904

1942

8/5

Lans. 3213'

5" - 3394'

Perf. Lansing

11000 acid

T.D. 3407'

Pump 387 Pot.

Gravity 35.

COMPLETED

Phillips

KANSAS

Map No. 138 Sec. 36 Twp. 2 R. 19WWell No. 3 Eltiste

Carter

Company

COMPLETED

Contractor

C NW NW

SECTION PLAT

0			

660 Ft. from N. Line

Ft. from S. Line

Ft. from E. Line

660 Ft. from W. Line

DAYTON POOL

Location

RECORD

Cased in, ft.

Sand

Gas

Oil

Total Depth 3402

PRODUCTION

1st 24 hrs. Nat.

1st 24 hrs. after shot

Gas Cu. Ft.

Dry Hole

Abandoned

Date

AUG 5 1942 19

S. J. LEWIS

Scout

Phillips

KANSAS

Map No. 138 Sec. 36 Twp. 2 R. 19WWell No. 3 Eltiste

Carter

Company

FIRST REPORT

Contractor

C NW NW

SECTION PLAT

0			

660 Ft. from N. Line

Ft. from S. Line

Ft. from E. Line

660 Ft. from W. Line

DAYTON POOL

Location XXX

RECORD

Cased in, ft.

Sand

Gas

Oil

Total Depth

PRODUCTION

1st 24 hrs. Nat.

1st 24 hrs. after shot

Gas Cu. Ft.

Dry Hole

Abandoned

Date

MAY 6 1942 19

S. J. LEWIS Scout