

Norton


KANSAS

SECTION 31 TOWNSHIP 2 RANGE 21 W

WELL NO. #1 Cox

COMPANY Jones, Shelburne & Farmer & Durbin-Bond

NORTH

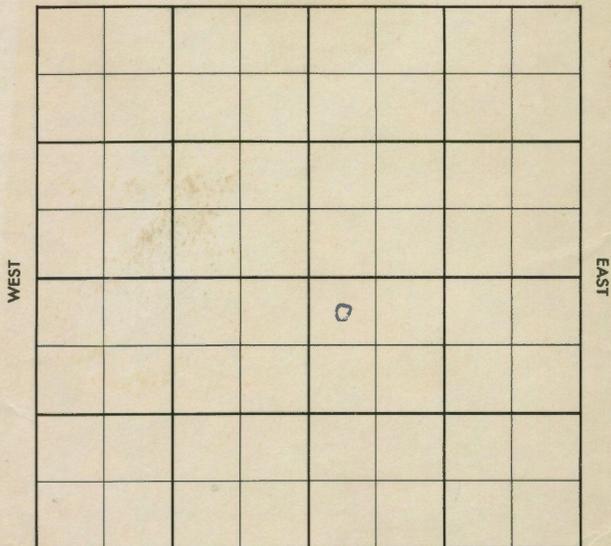

SOUTH

10

Norton

KANSAS

SEC. 31 TWP. 2 R. 21W

WELL NO. #1 Cox

COMPANY Jones Shelburne & Farmer & Durbin-Bond

CONTRACTOR J-S-F

Wildcat

\_\_\_\_\_ Ft. from N. Line


\_\_\_\_\_ Ft. from S. Line

\_\_\_\_\_ Ft. from E. Line

\_\_\_\_\_ Ft. from W. Line

NW NW SE

CSO - DHM & FO

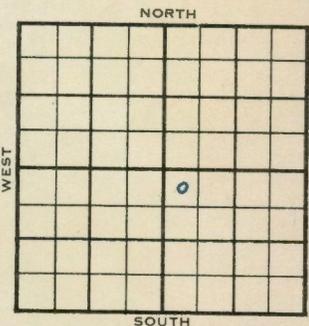

1955 ELEVATION 2320' REPORT

11/2 Comm 10-31-55  
Rng surf

11-16 8 5/8" @ 232/115

D&A

<u>Tops</u>	<u>Depth</u>	<u>Log</u>
Anh.	2027	
H.	3551	3550
Tr.	3575	3574
L. #	3591	3593
B.K.C.	3787	3784
A	3854	3854
T.D.	3880'	

ABANDONED

County Norton Elev. \_\_\_\_\_  
 Sec. 31 Twp. 2 Rge. 21W  
 Company Jones, Shelburne & Farmer & Durbin  
 FarmName Cox No. Bond 1

TOPS	DEPTH	LOG	DATUM	Loc. in Sec.
Anh.				NW NW SE
Tp.				
H.				
Tr.				
Dg.				
Bl.				
L.				Geol.
K.C.				Contr.
B.K.C.				
Ce.				<u>J-S-F</u>
C.				
M.				Pool
M.				<u>Wildcat</u>
K.				
Mz.				
Ma.				
V.				
S.				
S.				
A				
R.				
Pe.				
G.				
Tp.				

Date Comm. 10-31-55 GSO - DHM & FO  
ing. surface

T. \_\_\_\_\_  
 R. \_\_\_\_\_

County Norton Elev. 2320  
 Sec. 31 Twp. 2 Rge. 21W  
 Company Jones, Shelburne & Farmer & Durbin  
 FarmName Cox No. Bond 1

TOPS	DEPTH	LOG	DATUM	Loc. in Sec.
Anh.	<u>3027</u>			NW NW SE
Tp.				
H.	<u>3551</u>	<u>3550</u>	<u>1230</u>	
Tr.	<u>3575</u>	<u>3574</u>	<u>1254</u>	
Dg.				
Bl.				
L.	<u>3591</u>	<u>3593</u>	<u>1273</u>	Geol.
K.C.				Contr.
B.K.C.	<u>3787</u>	<u>3784</u>	<u>1464</u>	
Ce.				<u>J-S-F</u>
C.				
M.				Pool
M.				<u>Wildcat</u>
K.				
Mz.				
Ma.				
V.				
S.				
S.				
A	<u>3854</u>	<u>3854</u>	<u>1534</u>	ABANDONED
R.				
Pe.				
G.				
Tp.	<u>3880</u>	<u>3880</u>		

Date Comm. 10-31-55 NOV 16 1955  
8 5/8" @ 232/115

D & A