


Norton

KANSAS

Section 9 Township 2 Range 23WWell No. #1 WallachCompany Empire Drlg. & Somers

NORTH

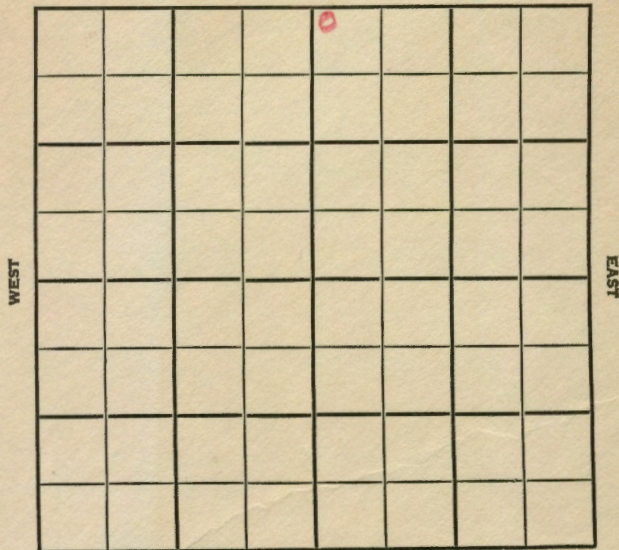

SOUTH

2

FORM 513 REV. SUNRAY

Twp. Pool.

Co. Facet.

FIRST REPORT

County Norton Elev. _____
 Sec. 9 Twp. 2 Rge. 23W
 Company Empire Drlg. & Somers
 Farm Name Wallach No. 1

TOPS	DEPTH	LOG	DATUM	Loc. in Sec.
Anh.				NW NW NE
TP.				
H.				
Tr.				
Dg.				
Bl.				
L.				Geol.
K.C.				Contr.
B.K.C.				Co. tools
Ce.				Pool
C.				Wildcat
M.				
M.				
K.				
Mz.				
Ma.				
V.				
S.				
S.				
A.				
R.				
PE.				
G.				
TD.				

Date Comm. 5-16-55 Skelly - DEM

8" @ 173 w/ 115

K-6