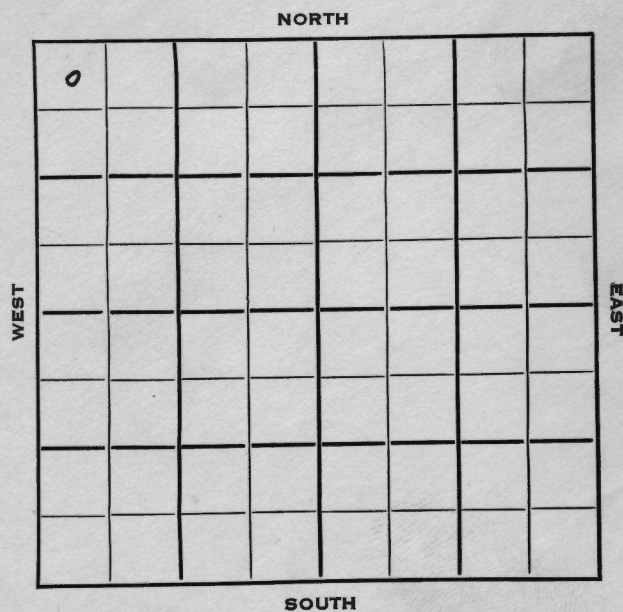


Section 18 Township 2 Range 23WWell No. 1 Sanderson "B"Company Jones, Shelburne & Farmer

4

SEC. <u>18</u>	TWP. <u>2</u>	R. <u>23W</u> ✓
WELL NO. <u>#1 Sanderson "B"</u> FARM		
COMPANY <u>Jones, Shelburne & Farmer</u>		
CONTRACTOR		

Wildcat.

330

Ft. from N. Line


Ft. from S. Line

Ft. from E. Line

330

Ft. from W. Line

NW NW NW
CSO - DHM

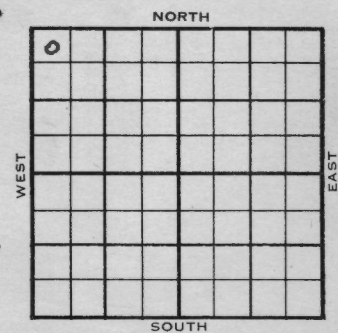

ELEVATION	REPORT
1954	2449'
4/14	Location
5/5	Spud 4-24-54 D & A TD 3750' 8" @ 275' Heeb 3410', Tor 3439', Lans 3455' DST 3469'-96' opn $\frac{1}{2}$ hr, rec 12' Mud, 950# DST 3569'-3600' opn $\frac{1}{2}$ hr, rec 6' socm 0# B KC 3646', Arb 3708' DST 3710'-15' opn $\frac{1}{2}$ hr, rec 12' Mud 1060# DST 3711'-20' opn 1 hr, rec 420' sw 900# Reagan 3728', Gr. 3733', TD 3750' D & A ABANDONED

County Norton State Kansas
 Sec. 18 (Blk. Twp.) 2 (Sur. Rge.) 23W Map No.
 Operator Jones, Shelburne & Farmer
 Well No. 1 Farm Sanderson "B"
 Elev. 2449 Location NW NW NW

330 Ft. From N Line NW

330 Ft. From W Line Quarter

1st. Report

Completion MAY 5 1954

Remarks Wildcat

Spudding Date 4-24-54

Drig. Data D & A TD 3750

8" @ 275 Heeb. 3410 Tor. 3439

Lans. 3455 DST 3469-96 open $\frac{1}{2}$ hr.

Rec. 12' mud 950# DST 3569-3600

open $\frac{1}{2}$ hr. Rec. 6' soom 0# B KC 3646

Arb. 3708 DST 3710-15 open $\frac{1}{2}$ hr. Rec.

12' mud 1060# DST 3711-20 open 1 hr.

Rec. 420' sw 900# Reagan 3728 Gr. 3733

TD 3750

D & A

J. G. McGEHEE

County Norton State Kansas
 Sec. 18 (Blk. Twp.) 2 (Sur. Rge.) 2 3W Map No.
 Operator Jones, Shelburne & Farmer
 Well No. 1 Farm Sanderson "B"
 Elev. Location NW NW NW

330 Ft. From N Line NW

330 Ft. From W Line Quarter

1st. Report APR 14 1954

Completion

Remarks CSO - DEN

Spudding Date

Drig. Data

Wildcat

Location

J. G. McGEHEE