


Norton

KANSAS


SECTION 26 TOWNSHIP 2S RANGE 23W

WELL NO. #1 Sanders

COMPANY J.O. Farmer & Brooks Hall

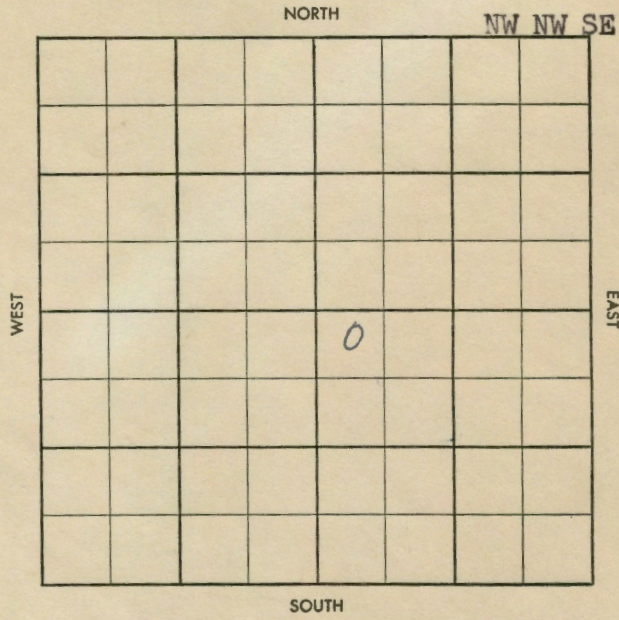

10

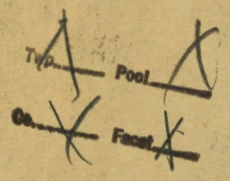

S-513-B

County Norton Elev. 23410 23440
 Sec. 26 Twp. 2 Rge. 23W
 Company J. O. Farmer & Brooks Hall
 Farm Name Sanders No. 1

TOPS	DEPTH	LOG	DATUM	Loc. in Sec.
Anh.	1922			NW NW SE
Tr.				38
H.	3368	3368		
Tr.	3399	3399		
Dg.				
B.L.				
L.	3412	3412		
K.C.				
B.K.C.	3599	3599		
Ce.	DST			
C.				
M.				
M.				
K.				
Mz.				
Mq.				
V.				
S.				
S.				
A.	3639	3639		
R.				
Pf.				
G.				
T.D.	3646			

ABANDONED
 0
 JUL 23 '58

Date Comm. 6-6-58 Phillips - DHM
 8" @ 206/150 JUN 18 '58
 - 42 lb - 30' socm 2' oil BHP
 40 DST 3642 - 46 lb 25' OCM
 5' oil BHP 760 5 1/2" 3640
 WOL JUN 25 '58 W 3646 1590 PHNT
 1/2" BOPH + 10' W 22' 1/2"
 4.16 BOPH 40-509 W JUL - 58 FU
 750' oil 350' W 9 hrs
 WOL JUL 15 '58 JUL 23 '58 T6A

Typ. Pool
 Co. Facet
WILDCAT

38

S-513-B

County Norton Elev. _____
 Sec. 26 Twp. 2 Rge. 23W
 Company J. O. Farmer & Brooks Hall
 Farm Name Sanders No. 1

TOPS	DEPTH	LOG	DATUM	Loc. in Sec.
Anh.				NW NW SE
Tr.				
H.				
Tr.				
Dg.				
B.L.				
L.				
K.C.				
B.K.C.				
Ce.				
C.				Farmer
M.				
M.				
K.				
Mz.				Wildcat
Mq.				
V.				
S.				
S.				
A.				
R.				
Pf.				
G.				
T.D.				

JUN 11 '58
 FIRST REPORT

Date Comm. 6-6-58 Phillips - DHM
 8" @ 206/150