


Section 6 Township 2 Range 24W
 Well No. #1 Coler
 Company Jones, Shelburne & Farmer

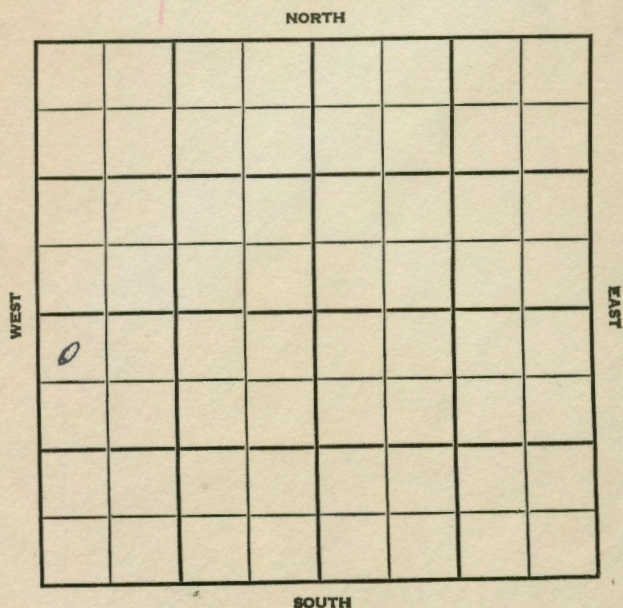

12

SEC. 6 TWP. 2 R. 24W
 WELL NO. #1 Coler FARM
 COMPANY Jones, Shelburne & Farmer
 CONTRACTOR

Co. Tools.

Wildcat.

330

Ft. from N. Line


Ft. from S. Line

Ft. from E. Line

330

Ft. from W. Line

NW NW SW

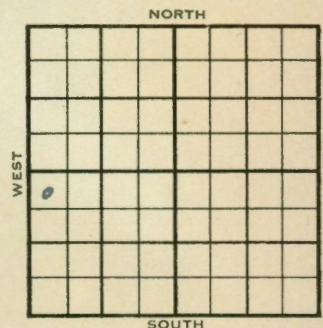

1954

ELEVATION

2511'

REPORT

11/17 M I R

12/1

Spud 11-15-54

D&A

TD 3775'

Anhy 2018', Heeb 3396', Mans 3438',
 B KC 3633', Gr. Wash 3726', Gr. 3772'

TD 3775'

D&A

ABANDONED

330	Ft. From	N	Line	SW
330	Ft. From	W	Line	Quarter
1st. Report				
Completion		DEC 1 1954		
Remarks		Wildcat		
Co. tools				
Spudding Date		11-15-54		

Drig. Data	D & A	TD 3775
Anhy 2018	Heeb. 3396	Lans. 3438
B KC 3633	Gr. wash 3726	Gr. 3772
TD 3775		

D & A

FABEN-GILSTRAP

County **Horton** State **Kansas**

Sec. **6** (Blk. **2** (Sur. **24W** Map No. _____)

Operator **Jones, Shelburne & Farmer**

Well No. **1** Farm **Coler**

Elev. _____ Location **NW NW SW**

330 Ft. From **N** Line **SW**

330 Ft. From **W** Line **Quarter**

1st. Report **NOV 17 1954**

Completion _____

Remarks _____

Co. tools

Spudding Date _____

Orig. Data _____

WILCOAT

Elev. _____ Loc. _____

0

FIRST REPORT

330	Ft. From	N	Line	SW
330	Ft. From	W	Line	Quarter
1st. Report NOV 17 1954				
Completion				
Remarks				
Co. tools				
Spudding Date				
Wildcat				

M I R

Wildcat

FABEN GILSTRAP