

DX 78-1


Norton

KANSAS

Section 20 Township 2 Range 24W

Well No. #1 Duensing

Company D.G. Hansen

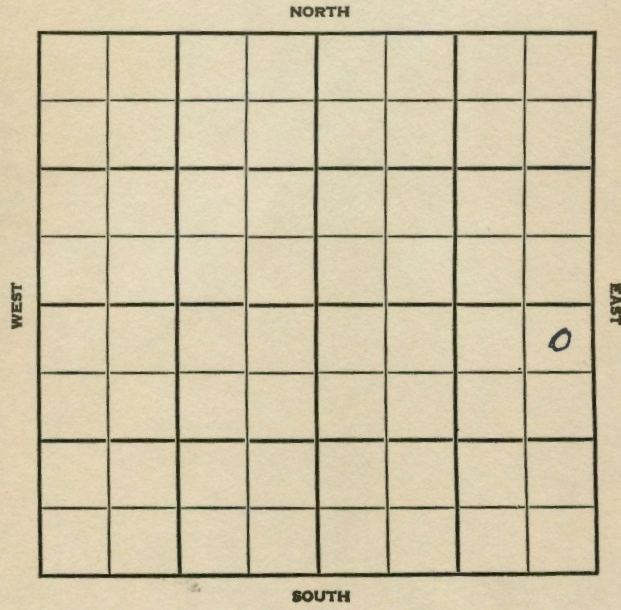

9

County Norton Elev. 2497
 Sec. 20 Twp. 2 Rge. 24W
 Company D. G. Hansen
 FarmName Duensing No. 1

TOPS	DEPTH	LOG	DATUM	Loc. in Sec.
Anh.	2025			NE NE SE
Tp. <u>How</u>	2218			
H.	3426			
Tr.	3457			
Dg.				
Bl.				
L.	3472			Geol.
K.C.				Contr.
B.K.C.	3662			<u>C & G</u>
Ce.				Pool
C.				<u>Wildcat</u>
M.				
Mz.				
Me.				
V.				
S.				
A.				
R.	3730			
PE.				
G.	3748			
TD.	3775			

Date Comm. Nov 21 58 Co's O & G DHM CSO DTH
 Location Nov 21 58 11-13-56 8 1/8
295' 200 DST 3476-3515 1 1/2
20" MW BHP 1150/20" BHP
DST 3607-3635 1 1/2 145' WM
+ 240' SOC SW BHP 1115/20"
D & O



WILDCAT

County Norton Elev. _____
 Sec. 20 Twp. 2 Rge. 24W
 Company D. G. Hansen
 FarmName Duensing No. 1

TOPS	DEPTH	LOG	DATUM	Loc. in Sec.
Anh.				NE NE SE
Tp.				
H.				
Tr.				
Dg.				
Bl.				
L.				Geol.
K.C.				Contr.
B.K.C.				<u>C & G</u>
Ce.				Pool
C.				<u>Wildcat</u>
M.				
Mz.				
Me.				
V.				
S.				
A.				
R.				
PE.				
G.				
TD.				



Date Comm. _____
 Location _____

Handwritten initials 'JB' in red ink.