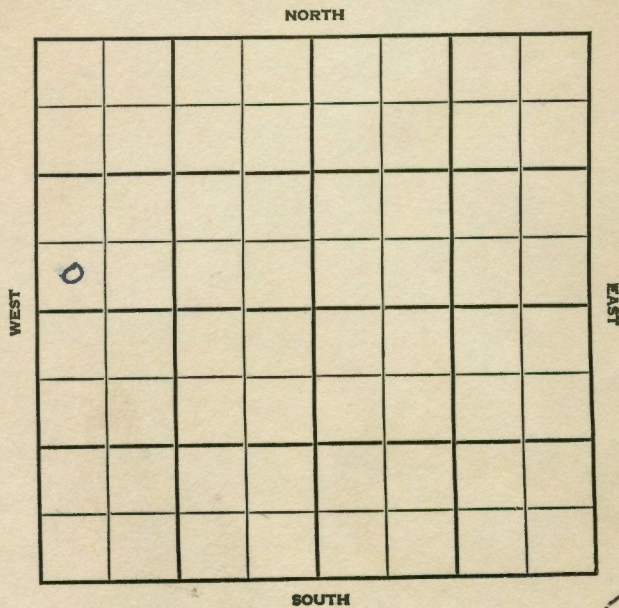


Section 26 Township 2 Range 24 WWell No. #1 SidmanCompany Jones, Shelburne & Farmer

5

SEC. 26 TWP. 2 R. 24W

WELL NO. #1 Sidman FARM

COMPANY Jones, Shelburne & Farmer

CONTRACTOR Co. Tools


Wildcat

_____ Ft. from N. Line

_____ Ft. from S. Line

_____ Ft. from E. Line

_____ Ft. from W. Line

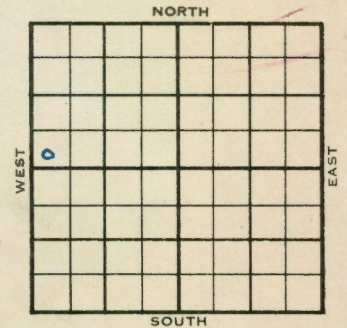

SW SW NW

CSO - DHM

1955 ELEVATION **2434'** REPORT

8/17 Comm 8-14-55
8" @ 210/130
Drlg 1860

8/31 Comm 8-14-55

Anh	1985	
H	3394	3394
Tr	3423	3427
L	3440	3442
BKC	3628	3628
G Wh	3695	3694
Gr	3723	3718
TD	3726	

8" @ 210/130 DST 3441-75 open $\frac{1}{2}$ hr.
 Rec 20' drlg mud 900/20" DST 3483-
 3522 open 1 hr Rec 60' mud 150'
 muddy sw 1120/30" DST 3576-3605
 open 1 hr Rec 15' socm 520/20"
 D & A

ABANDONED

County Norton Elev. 2434
 Sec. 26 Twp. 2 Rge. 24W
 Company Jones, Shelburne & Farmer
 FarmName Sidman No. 1

TOPS	DEPTH	LOG	DATUM	Loc. in Sec.
Anh.	<u>1985</u>			SW SW NW
TP.	<u>3394</u>	<u>3294</u>	<u>960</u>	
H.	<u>3423</u>	<u>3427</u>	<u>993</u>	
Tr.				
Dg.				
BL.				
L.	<u>3440</u>	<u>3442</u>	<u>1008</u>	Geol.
K.C.	<u>3628</u>	<u>3628</u>	<u>1194</u>	Contr.
B.K.C.				Co. tools
Ce.				
C.				
M.				Pool
M.				Wildcat
K.				
Mz.				
Ma.				
V.				
S.				
S.				
A				
R.				
PE.				
G.	<u>3695</u>	<u>3694</u>	<u>1260</u>	
	<u>3723</u>	<u>3718</u>	<u>1284</u>	
TD.	<u>3726</u>			

Date Comm. 8-14-55 AUG 31 1955
 8" @ 210/130 DST 3441-75 open $\frac{1}{2}$ hr.
 Rec. 20' drlg. mud 900/20" DST 3483-
 3522 open 1 hr. Rec. 60' mud
 150' muddy sw 1120/30" DST 3576-3605
 open 1 hr. Rec. 15' socm 520/20"
 D & A

County Norton Elev. 2434
 Sec. 26 Twp. 2 Rge. 24W
 Company Jones, Shelburne & Farmer
 FarmName Sidman No. 1

TOPS	DEPTH	LOG	DATUM	Loc. in Sec.
Anh.				SW SW NW
TP.				
H.				
Tr.				
Dg.				
BL.				
L.				Geol.
K.C.				Contr.
B.K.C.				Co. tools
Ce.				
C.				
M.				Pool
M.				Wildcat
K.				
Mz.				
Ma.				
V.				
S.				
S.				
A				
R.				
PE.				
G.				
TD.				

Date Comm. 8-14-55 AUG 7 1955 CSO - DHM
 8" @ 210/130 drlg. 1860

FIRST REPORT