


Norton

**KANSAS**

SECTION 12 TOWNSHIP 2 RANGE 25W

WELL NO. #1 Strayer

COMPANY Kaiser & Francis O&G

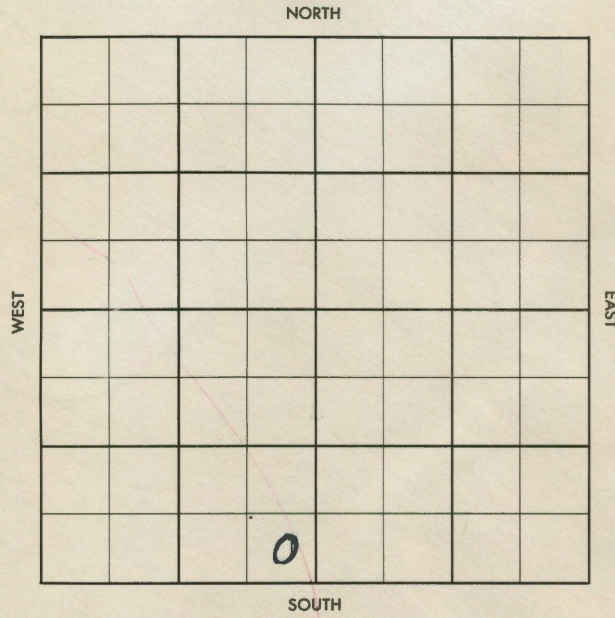

14

