


Section 17 Township 2 S Range 25 W

Well No. # 1 Bolliger

Company Jones, Shelburne & Farmer

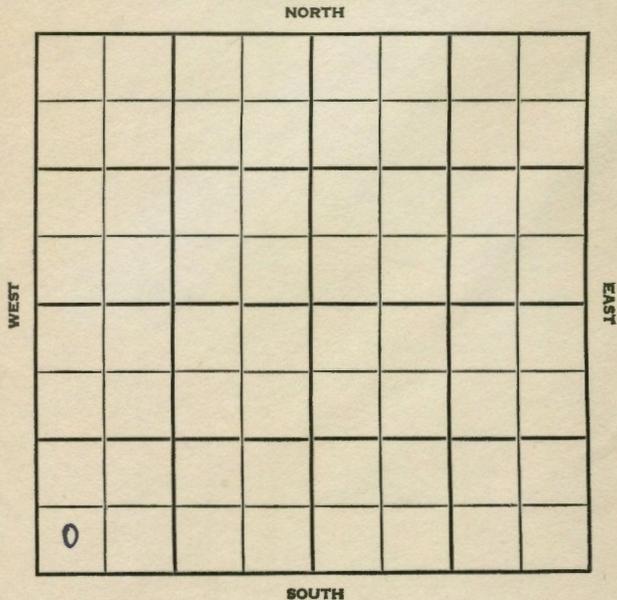

13

SEC. 17 TWP. 2S R. 25W

WELL NO. #1 Bolliger FARM

COMPANY Jones, Shelburne & Farmer

CONTRACTOR Co. Tools.


Wildcat.

\_\_\_\_\_ Ft. from N. Line

330 \_\_\_\_\_ Ft. from S. Line

\_\_\_\_\_ Ft. from E. Line

330 \_\_\_\_\_ Ft. from W. Line

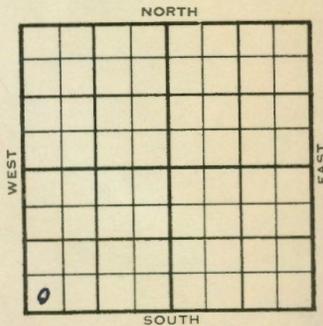

SW SW SW

1954 ELEVATION 2504' REPORT

12/8 Spud 12-6-54  
8" @ 270'  
WOC.

12/22 Spud 12-6-54  
D & A  
TD 3820'  
8" @ 270'

Anhy 2031' Top 3215' Heeb 3404', Tor 3431', Lans 3443' Cong 3754', Arb. 3781'

DST 3783'-91' opn 1 hr, rec 50' Muddy Wtr. 800#  
TD 3820'

Schlumberger Tops: Heeb 3394', Tor 3422', Lans 3432' BKC 3632' Cong 3756' Arb. 3782' Gr. Wash 3812' Gr. 3818'  
TD 3820'

D & X

ABANDONED

