


Decatur KANSAS

Section 3 Township 2 Range 26W

Well No. 1 Eckhart

Company Jones, Shelburne & Farmer

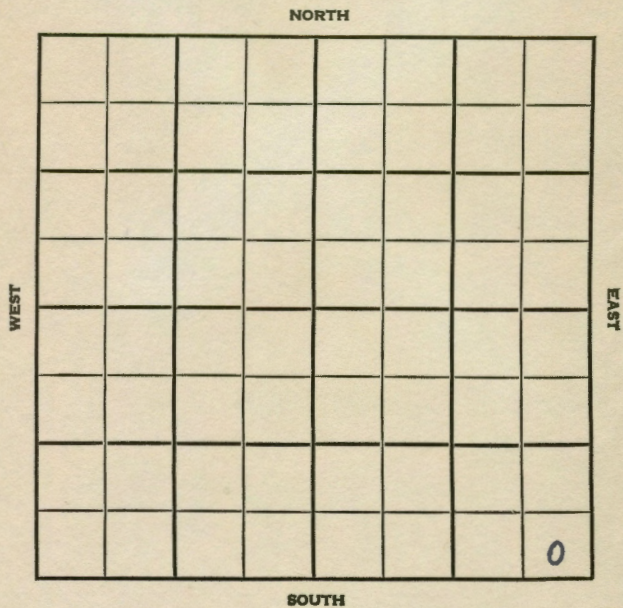

16

SECC.			TWP.			R.		
3			2			26 W		
WELL NO.								
# 1 Eckhart								
FARM								
COMPANY								
Jones, Shelburne & Farmer								
CONTRACTOR								

Co. tools

Wildcat


_Ft. from N. Line

330 Ft. from S. Line

330 Ft. from E. Line

Ft. from W. Line

SE SE SE

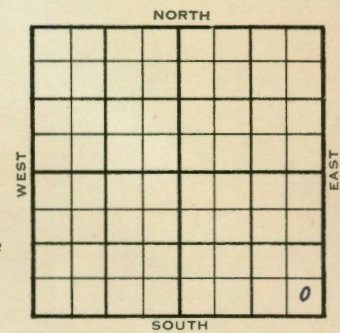

ELEVATION		REPORT
1954	2516'	
10/20	Spud 10-18-54 Anhy 1990'	
10/27	Drlg. 1995' Spud 10-18-54 D&A TD 3718' Anhy 1990' 8-5/8" @ 206' Heeb 3316', Tor 3346', Lans 3356', B KC 3558' 1/2 Granite wash 3664', Gr. 3706' TD 3718' DST 3198-3240', opn 1/2 hrs., rec. 445' SW, 1180# D&A	
		ABANDONED

DX-78

County Decatur State Kansas
 Sec. 3 (Blk. 2 (Sur. 26W Map No.
 (Twp.) (Rge.)
 Operator Jones, Shelburne & Farmer
 Well No. 1 Farm Eckhart
 Elev. 2516 Location SE SE SE




330 Ft. From S Line SE
330 Ft. From E Line Quarter
 1st. Report
 Completion OCT 27 1954
 Remarks Wildcat
Co. tools
 Spudding Date 10-18-54

Drlg. Data D & A TD 3718
Anhy 1990 8 5/8" @ 206 Heeb. 3316
Tor. 3346 Lans. 3356 B KC 3558
Granite wash 3664 Gr. 3706 TD 3718
DST 3198-3240 open 1/2 hr. Rec. 445' sw
1180#

D & A

FABEN GILSTRAP

County Decatur State Kansas
 Sec. 3 (Blk. 2 (Sur. 26W Map No.
 (Twp.) (Rge.)
 Operator Jones, Shelburne & Farmer
 Well No. 1 Farm Eckhart
 Elev. Location SE SE SE

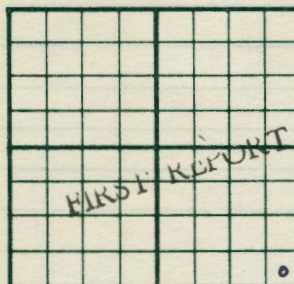

330 Ft. From S Line SE
330 Ft. From E Line Quarter
 1st. Report OCT 20 1954
 Completion
 Remarks
Co. tools
 Spudding Date 10-18-54

Drlg. Data Wildcat
Anhy 1990 drlg. 1998

FABEN GILSTRAP