


Section 5 Township 2 Range 26W

Well No. #1 Railsback

Company J. M. Huber

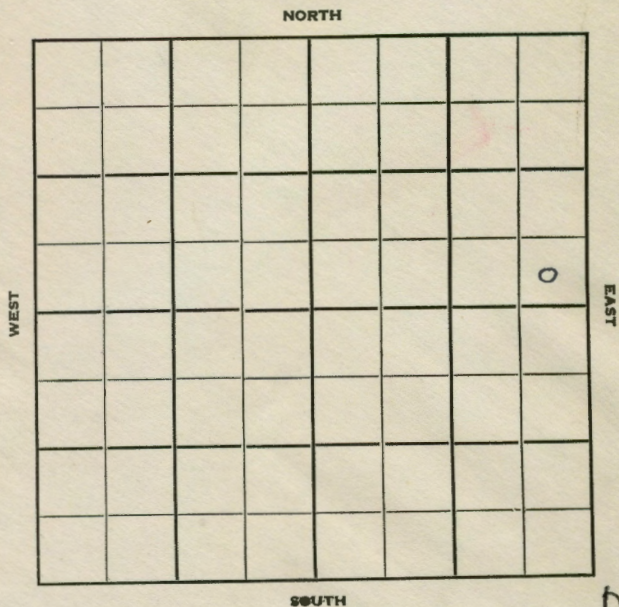


Sec. 5 Twp. 2 R. 26W

Well No. #1 Railsback Farm

J. M. Huber Company

Contractor

\_\_\_\_\_ Ft. from N. Line  
330 Ft. from S. Line  
330 Ft. from E. Line  
 \_\_\_\_\_ Ft. from W. Line  
 SE SE NE

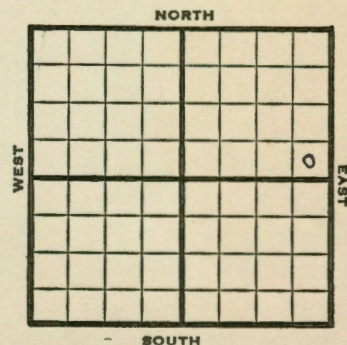

1952 **Elev. 2581'** REPORT

3/26 Spud 3-24-52  
 8" @ 95' WOC

4/1 **Anhy 2035**  
 DST 3388-3426 1/2 hr. 10' m  
 750# DST 3426-55 1 hr. 90' ocm  
 Drlg. 3455'

4/9 Spud 3-24-52  
 D&A TD 3790 8" @ 95  
**Anhy 2035**  
 DST 3388-3426 open 1 hr. rec. 10' mud  
 DST 3426-55 open 1 hr. rec. 90' ocm  
 Howard 3198 Top. 3238  
 Heeb. 3361 Lans. 3403  
 B KC 3603 Granite wash 3735  
 Granite 3782  
 TD 3790 D&A

**ABANDONED**

