


DX 78-1 Decatur

KANSAS

Section 16 Township 2 Range 26W

Well No. #1 R. G. Stapp

Company Fred Ayesh Oil

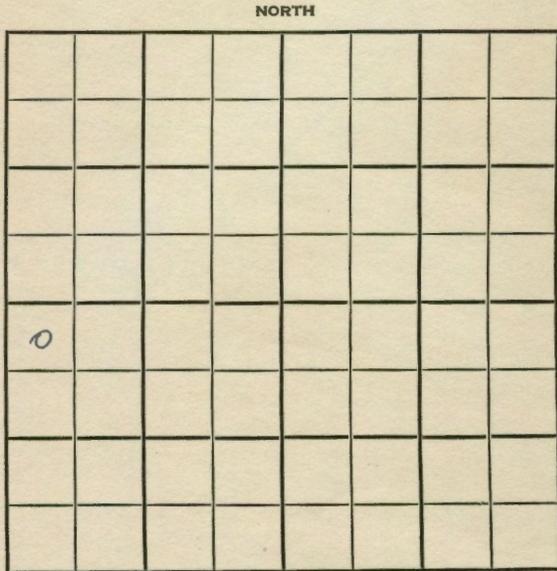

12

| | | |
|------|------|-----|
| SEC. | TWP. | R. |
| 16 | 2 | 26W |

WELL NO. #1 R.G. Stapp

COMPANY Fred Ayesh Oil

CONTRACTOR Sauvage

WILDCAT


_____ FT. FROM N. LINE

_____ FT. FROM S. LINE

_____ FT. FROM E. LINE

_____ FT. FROM W. LINE

NW NW SW

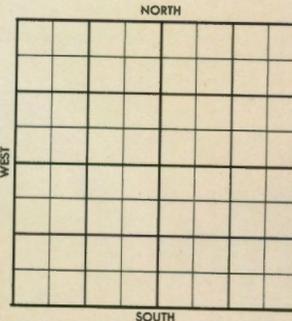

Magnolia - AC

| | | |
|------|--------------------|--------|
| 1956 | ELEVATION 2584' | REPORT |
|------|--------------------|--------|

5-29 MIR

6-13 Comm. 5-28-56
 8 5/8" @ 195 w/125
 DST 3482-3505 op 30 min. rec. 5' mud
 Press Off.
 DST 3623-50 op 15 min. rec. 5' mud,
 Press Off.
 D&A
 L. 3446'
 Log tops: H. 3426', L. 3463', Cgl. Sd
 3815', Gw. 3820'.
 TD 3835'

ABANDONED

