DX 78-1

Decatur KANSAS

Section 18 Township 2 Range 26W

Well No. 1 Thomson

Company Jones, Shelburne & Farmer

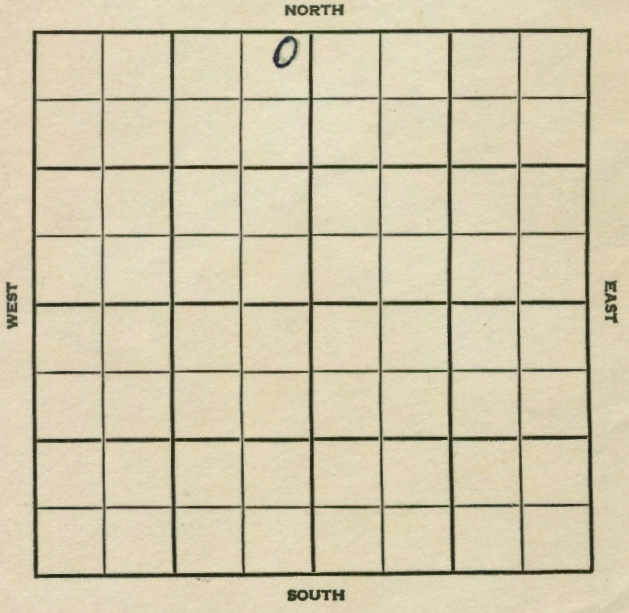

3

Decatur KANSAS

SEC. 18 | TWP. 2 | R. 26W

WELL NO.

#1 Thomson FARM

COMPANY

Jones, Shelburne & Farmer

CONTRACTOR

Co. Tools

Wildcat

_____ Ft. from N. Line

_____ Ft. from S. Line

_____ Ft. from E. Line

_____ Ft. from W. Line

NENENW

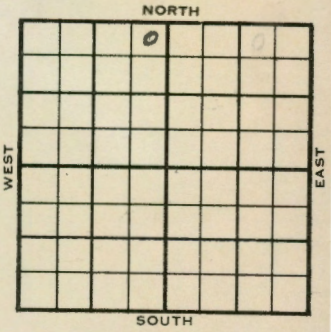

Shell BHM

1955	ELEVATION 2635' REPORT
7/1	Comm 6-29-55 8" @ 248/135 Drlg. 3235 Tops: Depth Anh. 2105
7/13	Spud 6-29-55 8" @ 248 w/135 DST 3398-3465, open 1 hr rec 245' muddy SW 1040/20" DST 3478-3520 open 1 hr rec 195' SOCM SW 1040/20" D & A Tops Depth Log Anh 2105 Tp. 3262 3258 Tr. 3454 L. 3464 3465 Marm. 3678 C 3788 G. 3825' TD 3871' D & A ABANDONED

DX-78

FORM 513 REV. SUNRAY

County Decatur Elev. 2635 Co.

Sec. 18 Twp. 2 Rge. 26W

Company Jones, Shelburne & Farmer

Farm Name Thomson No. 1

TOPS	DEPTH	LOG	DATUM
Anh.	2105		
Tp.	3262	3258	623
H.			
Tr.		3454	819
Dg.			
Bl.			
L.	3464	3465	830
K.C.			
B.K.C.			
Ce. Marm		3678	1043
C.		3788	1153
M.			
M.			
K.			
Mz.			
Mq.			
V.			
S.			
S.			
A			
R.			
PE.		3825	1190
G.			
T.D.	3871	3871	

Loc. in Sec. NE NE NW

Geol.

Contr. Co. tools

Lse.

Pool Wildcat

ABANDONED

JUL 13 1955

No.

Date Comm. 6-29-55

Sec.

8" @ 248/135 DST 3398-3465 open 1 hr. Rec. 245' muddy sw 1040/20" DST 3478-3520 open 1 hr. Rec. 195' socmsw 1040/20"

T.

D & A

R.

FORM 513 REV. SUNRAY

County Decatur Elev. Co.

Sec. 18 Twp. 2 Rge. 26W

Company Jones, Shelburne & Farmer

Farm Name Thomson No. 1

TOPS	DEPTH	LOG	DATUM
Anh.	2105		
Tp.			
H.			
Tr.			
Dg.			
Bl.			
L.			
K.C.			
B.K.C.			
Ce.			
C.			
M.			
M.			
K.			
Mz.			
Mq.			
V.			
S.			
S.			
A			
R.			
PE.			
G.			
T.D.			

Loc. in Sec. NE NE NW

Geol.

Contr. Co. tools

Pool Wildcat

FIRST REPORT

JUL 6 55

Date Comm. 6-29-55 Shell - DHM

8" @ 248/135 drlg. 3235

5 22