

n 252A 5M 8-24 16529


Map No. Kansas Sec. 25 Twp. 2 R. 26 W
 Well No. #1 Reager Farm
Marland O & R. Company

990 Ft. from N. Line

Ft. from S. Line

Ft. from E. Line

990 Ft. from W. Line

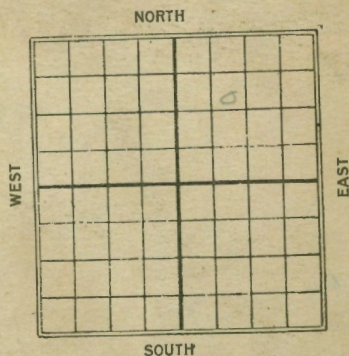

Date 1925 REPORT


4/23 S.D. 2400

6/1 3575

9/9 Abandoned 3980

Form 51 5M 11-23 13896

Map No. Kansas Sec. 25 Twp. 2 R. 26 W
 Well No. #1 Reager Farm
Marland O & R. Company

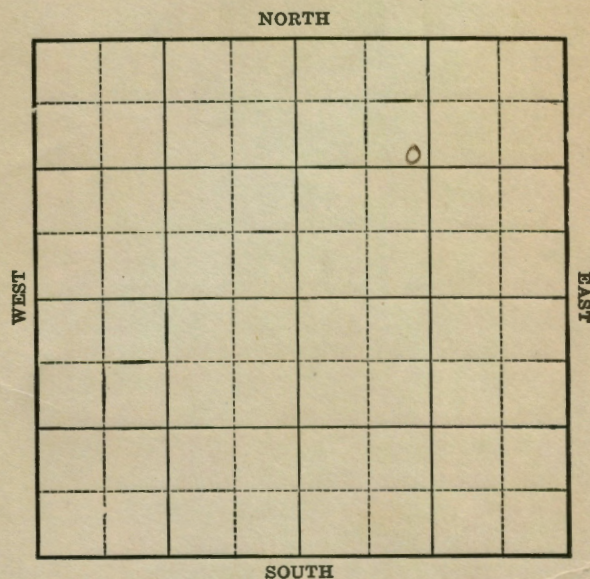

Location

Rig Up

Drilling Remarks:

Drilling Remarks:

RECORD

PRODUCTION

Cased in. ft.

1st 24 hrs. Nat.

Sand

1st 24 hrs. after shot

Gas

Gas cu. ft.

Oil

Dry Hole

Total Depth

Abandoned

MAP No. _____ SEC. 25 TWP. 25 R. 26NWELL No. 1 ReagerMarland Oil

COMPANY

CONTRACTOR

SECTION PLAT

		0	

_____ FT. FROM N. LINE

_____ FT. FROM S. LINE

_____ FT. FROM E. LINE

_____ FT. FROM W. LINE

LOCATION _____

RIG UP _____

DRILLING AND REMARKS:

RECORD

CASED _____ IN. _____ FT.

SAND _____

GAS _____

OIL _____

TOTAL DEPTH 3941

PRODUCTION

1ST 24 HRS. NAT. _____

1ST 24 HRS. AFTER SHOT _____

GAS _____ CU. FT.

DRY HOLE ☒ABANDONED ☒

DATE

8/25 1925

SCOUT

MAP No. _____ SEC. 25 TWP. 25 R. 26WELL No. William Reager #1Marland

COMPANY

CONTRACTOR

SECTION PLAT

		0	

_____ FT. FROM N. LINE

_____ FT. FROM S. LINE

_____ FT. FROM E. LINE

_____ FT. FROM W. LINE

LOCATION _____

RIG UP _____

DRILLING AND REMARKS:

3938 } sand
3941 }

RECORD

CASED _____ IN. _____ FT.

SAND _____

GAS _____

OIL _____

TOTAL DEPTH 3941

PRODUCTION

1ST 24 HRS. NAT. _____

1ST 24 HRS. AFTER SHOT _____

GAS _____ CU. FT.

DRY HOLE ☒ABANDONED ☒

DATE

192

SCOUT

Map No. KANSAS Sec. 25 Twp. 2 R. 26NWell No. #1 ReagerMarland Oil Co. Company

Contractor

FIRST REPORT

SECTION PLAT

990 Ft. from N. Line

Ft. from S. Line

Ft. from E. Line

990 Ft. from W. Line

Location

Rig up

Drilling and Remarks:

S.D. 2400'

RECORD

Cased in, ft.

Sand

Gas

Oil

Total Depth

PRODUCTION

1st 24 hrs. Nat.

1st 24 hrs. after shot

Gas Cu. Ft.

Dry Hole

Abandoned

Date

APR 23 1925

M. A. BENEAR

Scout

Map No. KANSAS Sec. 25 Twp. 2 R. 26NWell No. #1 ReagerMarland Oil Co. Company

Contractor

SECTION PLAT

990 Ft. from N. Line

Ft. from S. Line

Ft. from E. Line

990 Ft. from W. Line

ABANDONED

Location

Rig up

Drilling and Remarks:

T.D. 3980Ita.

RECORD

Cased in, ft.

Sand

Gas

Oil

Total Depth

PRODUCTION

1st 24 hrs. Nat.

1st 24 hrs. after shot

Gas Cu. Ft.

Dry Hole

Abandoned

Date

SEP 9 - 1925

S. J. LEWIS

Scout