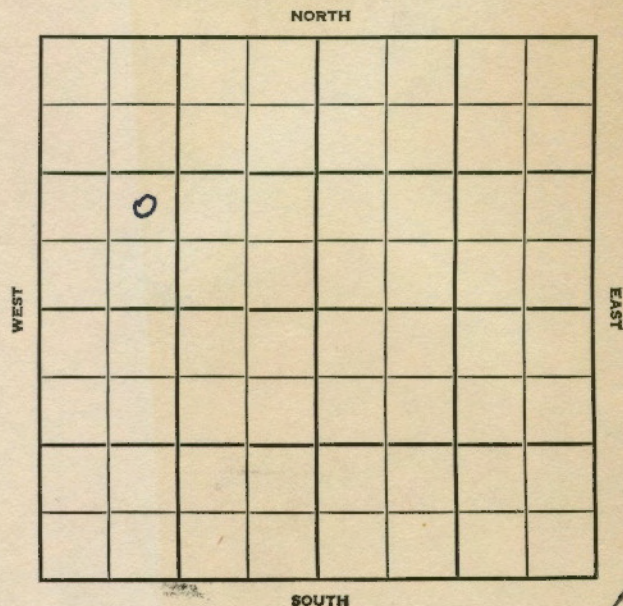


Section 6 Township 2 Range 27WWell No. 1 VehlinCompany Franco-Central

SEC.	TWP.	R.
6	2	27W

WELL NO.

1 Vehlin

FARM

COMPANY

Franco-Central

CONTRACTOR

Sauvage
Wildcat

_____ Ft. from N. Line

990


_____ Ft. from S. Line

_____ Ft. from E. Line

990

_____ Ft. from W. Line

NE SW NW

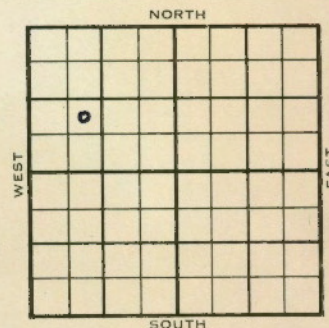

1954

ELEVATION

2562

REPORT

4/10

Spdg 7-30-54
8" @ 265
Drlg. 2820

8-11

Spdg 7-30-54
D&A
TD 3961
8" @ 265

Heeb 3356 Tor. 3386 Lans. 3401

DST 3366-3405 open $\frac{1}{2}$ hr. Rec. 4' mud
150#DST 3418-48 open $\frac{1}{2}$ hr. Rec. 7' mud
VSSO 850#

DST 3474-3515 failed

DST 3485-3515 open $\frac{1}{2}$ hr. Rec 5' mud
30#

BKC 3600 Sd/ 3773 Arb. 3850

TD 3961

D&A

ABANDONED

County Decatur State Kansas
 Sec. 6 (Bk. 2 (Sur. 27W Map No.
 Operator Franco-Central
 Well No. 1 Farm Vehlin
 Elev. 2562 Location NE SW NW



990 Ft. From S Line NW
 990 Ft. From W Line Quarter
 Ist. Report
 Completion AUG 11 1954
 Remarks Wildcat
Sauvage - Contr.
 Spudding Date 7-30-54

Drlg. Data D & A TD 3961
8" @ 265 Heeb. 3356 Tor. 3386
Lans. 3401 DST 3366-3405 open $\frac{1}{2}$ hr.
Rec. 4' mud 150# DST 3418-48 open
 $\frac{1}{2}$ hr. Rec. 7' mud VSSO 850#
DST 3474-3515 failed DST 3485-3515
open $\frac{1}{2}$ hr. Rec. 5' mud 30# B KC 3600
Sd/ 3773 Arb. 3850 TD 3961
D & A

78

County Decatur State Kansas
 Sec. 6 (Bk. 2 (Sur. 27W Map No.
 Operator Franco-Central
 Well No. 1 Farm Vehlin
 Elev. Location NE SW NW



990 Ft. From S Line NW
 990 Ft. From W Line Quarter
 Ist. Report AUG 4 1954
 Completion
 Remarks
Sauvage - Contr.
 Spudding Date 7-30-54

Drlg. Data Wildcat
8" @ 265 drlg. 2820

J. G. McGEHEE