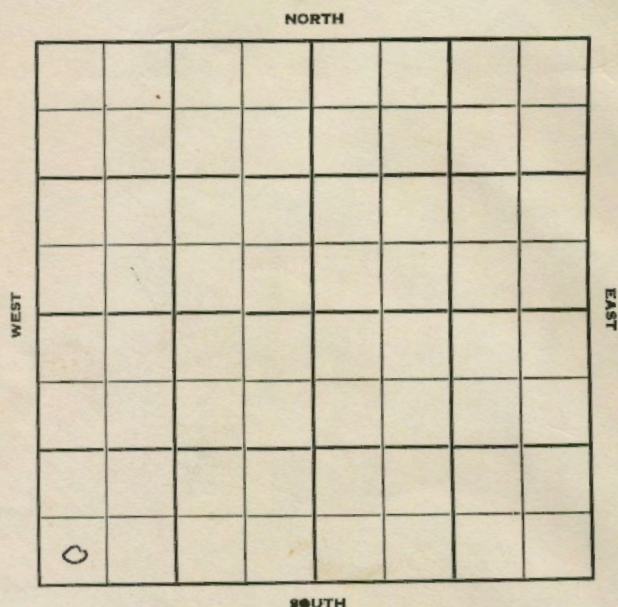


Section 15 Township 2 Range 27WWell No. #1 MonaghanCompany E. K. Carey

SOUTH

12

Sec. 15 Twp. 2 R. 27 WWell No. # 1 Monaghan Farm

E. K. Carey Company

Peel Drlg. Contractor

Wildcat

Ft. from N. Line


330 Ft. from S. Line

Ft. from E. Line

330 Ft. from W. Line

SW SW SW

MCPC has SE of 14

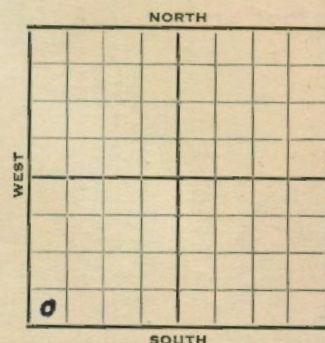

SOUTH

1952 **Elev. 2605'** REPORT

7/23 Spud 7-16-52
8" @ 238' **Anhy 2145'**
Drlg. 2975'

7/30 **Heeb 3382' Lans. 3490'**
DST 3498-3550, 1/2 hr, 120' O & GCM
1180#
DST 3564-3625' ?, 365' O & GCM 695#
Drlg. 3875'

8/6 **B KC 3692 Cong. 3828**
Granite wash 3978 Granite 4009'
RTD 4015 5" @ 3685'

8/13 CO 3650 8/3594-98 8/3602-06
SSO 24/3601-07 24/ 3592-99
200' fill up of oil & 6 1/2 boilers
oil 1 1/2 hrs. 500 A 2150' wtr. &
200' oil fill up 14 hrs. set plug
@ 3680'

8/20 Sq all perfs. 12/3564-74 PB 3548'
16/3528-32 500' wtr & SSO
16/3514-18, no help Sq off.
C/O 3654' 1 BOPH

8/27 NR
9/3 Sq. all perfs. 12-3603-06
16/3594-98 500 A S/ 1 1/2 Boph,
Set plug 3580 9/3567-69 500 A
S/4 Boph Set plug 3550'
16/ 3514-18 20/ 3528-33 500 A
S/ 1 1/2 Boph Drove all plugs.

OVER

1952

562SIS

9/10 POP

9/17 NR

9/24 P/6 BO plus 40 BWPD

10/1 NR

10/8 "

10/15 P 26 BOPD

10/22 NR

10/29 Spud 7-16-52

Oil well TD 4015' 8" @ 238

Anhy 2145' Top 3332' Heeb 3450'

Lans. 3490'

DST 3498-3550 open $1\frac{1}{4}$ hr. rec 30' oil
30' OCM, 60' SOCM 1180#

DST 3564-3625 open $\frac{1}{2}$ hr. rec 55' oil
310' O & GCM 695# B KC 3692'

Cong. 3828' Gr. Wash 3978'

Granite 4009'

TD 4015' 5" @ 3685' CO to 3650'

8/3594-98 8/3602-06 FU 200' oil

2 hr. 24/3601-07 125' oil 15 min

24/3592-99 FU 200' wtr. 6 bailers

oil $1\frac{1}{2}$ hr. 500 A FU 2150' wtr.

200' oil 14 hr. SP 3680 12/3564-74

FU 800' wtr. 200' oil PB 3548

16/3528-32 500' wtr. SSO

16/3514-18 CO to 3654 1 BOPH

12/3603-06 16/3594-98 500 A

S/ $1\frac{1}{2}$ BOPH SP 3580 9/3567-69

500 A S/4 BOPH SP 3550 16/3514-18

20/3528-33 500 A S/4 BOPH SP 3550

500 A S/ $1\frac{1}{2}$ BOPH P/65 BO 40 BWPD

P/20 BOPD 45 BW 17 BOPD P/18 BOPD

P/26 BOPD

Comp. 24 BOPD 70% wtr.

COMPLETED

County **Decatur** State **Kansas**
 Sec. **15** (Blk.) **2** (Sur.) **27W** Map No.
 Operator **E. K. Carey**
 Well No. **1** Farm **Monaghan**
 Elev. Location **SW SW SW**
 330 Ft. From **S** Line **SW**
 330 Ft. From **W** Line Quarter
 Ist. Report **JUL 23 1952**
 Completion
 Remarks **MCPC has SE of 14**
Peel Drlg. - Contr.
 Spudding Date **7-16-52**
 Drlg. Data **Wildcat**
8" @ 238 Anhy 2145 drlg. 2975

J. G. McGEHEE

County **Decatur** State **Kansas**
 Sec. **15** (Blk.) **2** (Sur.) **27W** Map No.
 Operator **E. K. Carey**
 Well No. **1** Farm **Monaghan**
 Elev. **2605** Location **SW SW SW**
 330 Ft. From **S** Line **SW**
 330 Ft. From **W** Line Quarter
 Ist. Report
 Completion **OCT 29 1952**
 Remarks **Wildcat**
Peel Drlg. - Contr.
 Spudding Date **7-16-52**
 Drlg. Data **Oil well TD 4015**

8" @ 238 Anhy 2145 Top. 3332

Heeb. 3450 Lans. 3490 DST 3498-3550

open $1\frac{1}{4}$ hr. Rec. 30' oil 30' ocm

60' socm 1180# DST 3564-3625 open $\frac{1}{2}$ h

Rec. 55' oil 310' o & gcm 695#

B KC 3692 Cong. 3828 Gr. Wash 3978

Granite 4009 TD 4015 5" @ 3685

CO to 3650 8/ 3594-98 8/ 3602-06

FU 200' oil 2 hr. 24/ 3601-07 125' oil

15 min. 24/ 3592-99 FU 200' wtr.

6 bailers Oil $1\frac{1}{2}$ hr. 500 A FU 2150'

wtr. 200' oil 14 hr. SP 3680

12/ 3564-74 FU 800' wtr. 200' oil

PB 3548 16/ 3528-32 500' wtr. SS0

J. G. McGEHEE

562515

Orig. Data

16/ 3514-18 CO to 3654 1 boph
 12/ 3603-06 16/ 3594-98 500 A
 S/ $1\frac{1}{2}$ boph SP 3580 9/ 3567-69 500 A
 S/ 4 boph SP 3550 16/ 3514-18
 20/ 3528-33 500 A S/ 4 boph SP 3550
 500 A S/ $1\frac{1}{2}$ boph P/ 65 bo 40bwpd
 P/ 20 bopd 45 bw 17 bopd P/ 18 bopd
 P/ 26 bopd Comp. 24 bopd 70% wtr.

NOV 5 1952

