


Section 15 Township 2 Range 27W
Well No. 2 Monaghan
Company H. E. Zoller & E. K. Carey

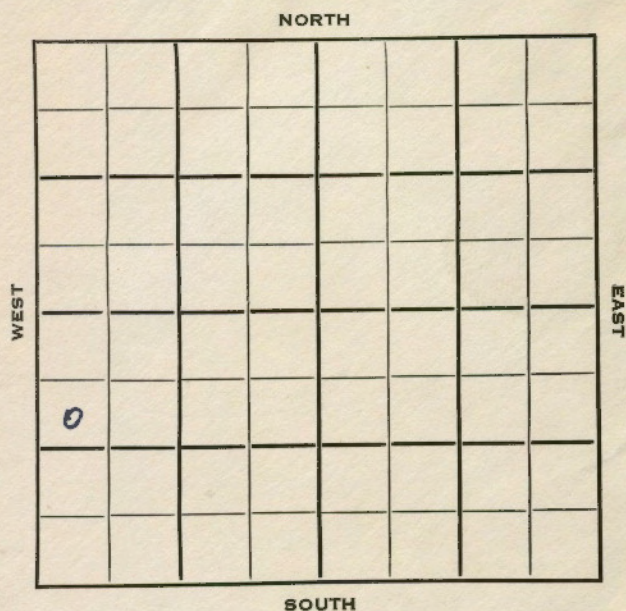

12

15	2	27 W	✓
WELL NO.			
# 2 Monaghan			FARM
COMPANY			
H.E. Zoller & E. K. Carey			
CONTRACTOR			

K & E Drlg.
Monaghan Pool


990 Ft. from N. Line

Ft. from S. Line

_____ Ft. from E. Line

330 Ft. from W. Line


SW NW SW

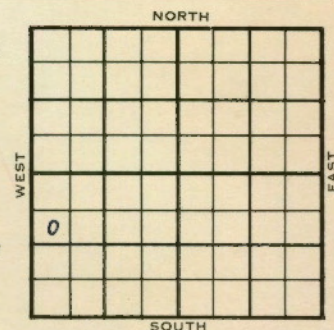

1954	ELEVATION 2601'	REPORT
2/17	Location	
2/24	"	
3/3	8" @ 208 w/135 Drlg. 2905'	
3/10	Lans. 3480' DST 3490-3545, 1/2 hr, 250' gas, 10' clean oil, 250' MCO 950# RTD 3580 5" @ 3580	
3/17	RTD cor. 3590' 5" @ 3589 WOCT	
3/24	24/3511-17 1½ bailers oil per hr. 1500 A S/14 BOPH 72 hrs. POP	
3/31	NR	
4/7	Spud 2-25-54 Oil Well TD 3590' 8" @ 208' Lans 3480' DST 3490-3545', opn ½ hrs., rec. 250' gas, 10' clean oil, 250' MCO, 950# TD 3590' 5" @ 3589' CO to 3590', 24/3511-17, 1½ bailers oph, 1500A S/14 boph 72 hrs., P/60 bopd Comp. 170 bopd 4% wtr.	
COMPLETED		

DX-78

County Decatur State Kansas
 Sec. 15 (Blk. 2 (Sur. 27W Map No.
 Operator H. E. Zoller & E. K. Carey
 Well No. 2 Farm Monaghan
 Elev. 2601 Location SW NW SW

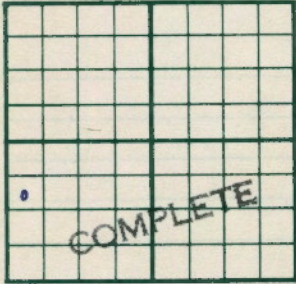


990 Ft. From N Line SW
330 Ft. From W Line Quarter
 1st. Report
 Completion APR 7 1954
 Remarks Monaghan Pool
K & E Drlg. - Contr.
 Spudding Date 2-25-54

Drlg. Data Oil well TD 3590
8" @ 208 Lans. 3480 DST 3490-3545
open $\frac{1}{2}$ hr. Rec. 250' gas 10' clean oil
250' mco 950# TD 3590 5" @ 3589
CO to 3590 24/ 3511-17 1 $\frac{1}{2}$ bailers oph
1500 A S/ 14 boph 72 hr. P/ 60 bopd
Comp. 170 bopd 4% wtr.

J. G. McGEHEE

County Decatur State Kansas
 Sec. 15 (Blk. 2 (Sur. 27W Map No.
 Operator H. E. Zoller & E. K. Carey
 Well No. 2 Farm Monaghan
 Elev. Location SW NW SW

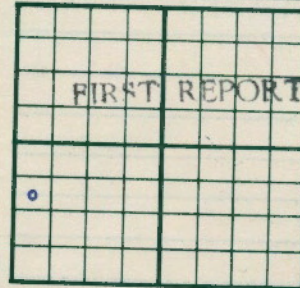

990 Ft. From N Line SW
330 Ft. From W Line Quarter
 1st. Report FEB 17 1954
 Completion
 Remarks
K & E Drlg. - Contr.
 Spudding Date

Drlg. Data Monaghan Pool

Location

J. G. McGEHEE