


SEC. 16 TWP. 2 R. 27W ✓

WELL NO. 1 Pelkey FARM
COMPANY H. E. Zoller & E. K. Carey
CONTRACTOR Mallonne

_____ Ft. from N. Line
990 _____ Ft. from S. Line
330 _____ Ft. from E. Line
_____ Ft. from W. Line

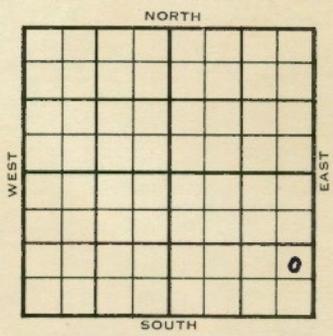

NE SE SE


1953 ELEVATION 2625' REPORT

11/4 Location
11/11 "
11/18 "
12/16 MICT
1954 NR
1/13 NR
1/20 "
3/3 Spud 11-17-53
Oil Well
TD 3628'
8" @ 258'
Anhy 2162', Heeb 3453', "ans 3494'
TD 3610'
5" @ 3607'
DD 3628'
212/3582-86', S/3 bwph
PB 3560', 12/3532-36, 1000A
s/26 boph 4 hrs.
P/36 boph
Comp. 190 bopd

COMPLETED

Section 16 Township 2 Range 27W

Well No. #1 Pelkey
Company H.E. Zoller & E.K. Carey

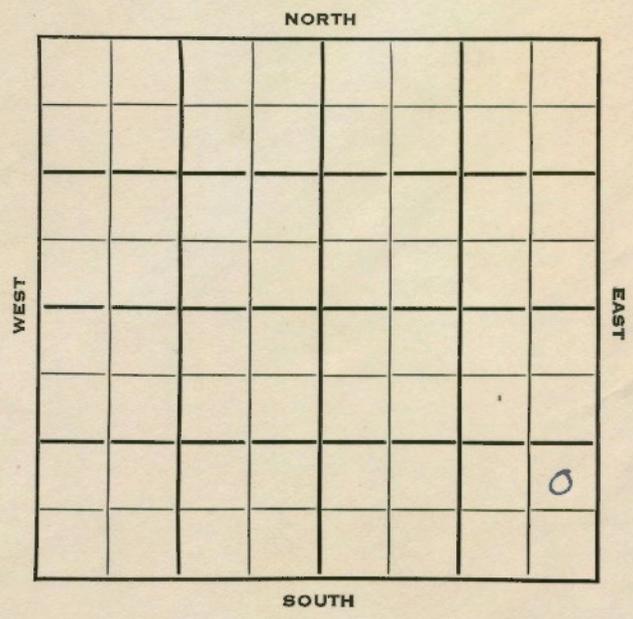

16

