

SEC. 16 TWP. 2 R. 27W

WELL NO. #2 Pelkey FARM

COMPANY H.E. Zoller & E. K. Carey

CONTRACTOR K & E Drlg.

Monaghan Pool

330 Ft. from N. Line

330 Ft. from S. Line

330 Ft. from E. Line

Ft. from W. Line

NE NE SE

1955 ELEVATION 2606' REPORT

2/9 M I R

5/25 Heeb sh 3444; Lsg. 3481;
 TD 3592; 8" 211
 DST 3439-3529 open 45 min., rec 110'
 ocm, 785#; RTD 3592; 5" 3589; CO 3520;
 32/3503-11, swb 3 bo 2 bwph 4 hrs;
 20/3481-86; swb 3 bo 2 bwph 4 hrs;
 sqz all perfs; CO 3490; 16/3481-86;
 sso; 1000 A; swb 7½ boph 6 hrs; Phy.
 pmp 145 bopd 10% wtr. from Lsg.
 3481-86

COMPLETED

DX-78

DX 78-1


Decatur

KANSAS

Section 16 Township 2 Range 27W

Well No. #2 Pelkey

Company H.E. Zoller & E.K. Carey

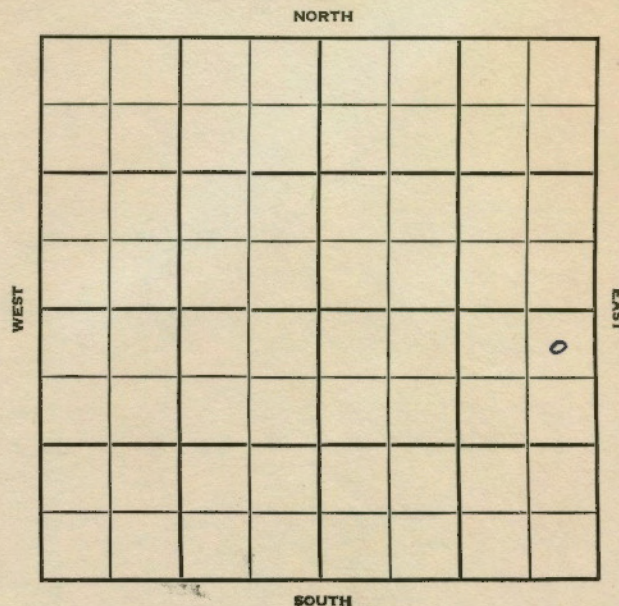

9

FABEN GILSTRAP