


Section **22** Township **2** Range **27W**

Well No. **1 Monaghan**

Company **Henderson Oil**

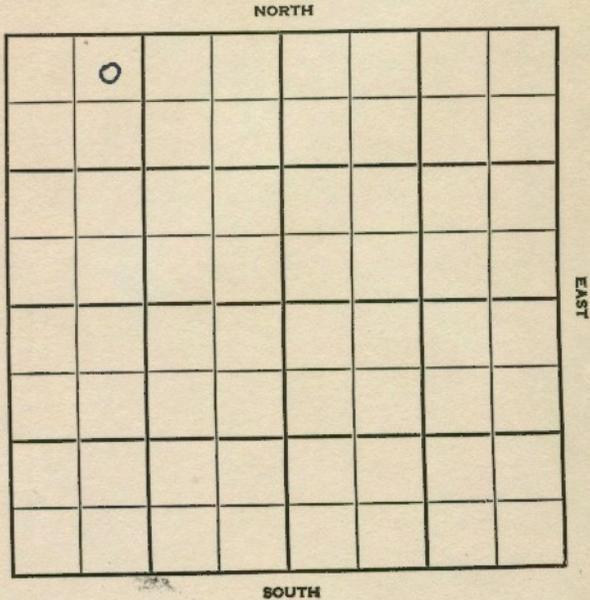

4

SEC.	22	TWP.	2	R.	27W
WELL NO.	<b>1 Monaghan</b>				FARM
COMPANY	<b>Henderson Oil</b>				
CONTRACTOR	<b>Hay</b>				


**Monaghan Pool**

330 Ft. from N. Line

\_\_\_\_\_ Ft. from S. Line

\_\_\_\_\_ Ft. from E. Line

990 Ft. from W. Line

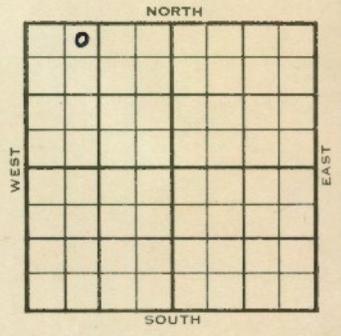

NE NW NW

	ELEVATION	REPORT
1954	<b>2610</b>	
7/28	Location	
8-11	Spdf 7-28-54	
	D&A	
	TD 3710	
	8" @ 450	
	<b>Lans. 3500</b>	
	DST 3514-38 <del>open</del> 1 hr. Rec. 25' so&gcm	
	50#	
	DST 3541-76 open 1 hr. Rec. 2' free oi.	
	16' socm 30' mud 740#	
	<b>BKC 3705</b>	
	TD 3710	
	D&A	
	<b>ABANDONED</b>	

County Decatur State Kansas  
 Sec. 22 (Blk. 2 (Sur. 27W Map No.  
 Operator Henderson Oil  
 Well No. 1 Farm Monaghan  
 Elev. 2610 Location NE NW NW

0				

330 Ft. From N Line NW  
990 Ft. From W Line Quarter  
 1st. Report \_\_\_\_\_  
 Completion 406 11 1954  
 Remarks Monaghan Pool  
Hay - Contr.  
 Spudding Date 7-28-54

Drig. Data D & A TD 3710  
8" @ 450 Lans. 3500 DST 3514-38  
open 1 hr. Rec. 25' so & gcm 50#  
DST 3541-76 open 1 hr. Rec. 2' free oil  
16' socm 30' mud 740# B KC 3705  
TD 3710

D & A

79

County Decatur State Kansas  
 Sec. 22 (Blk. 2 (Sur. 27W Map No.  
 Operator Henderson Oil  
 Well No. 1 Farm Monaghan  
 Elev. \_\_\_\_\_ Location NE NW NW

0				

330 Ft. From N Line NW  
990 Ft. From W Line Quarter  
 1st. Report JUL 28 1954  
 Completion \_\_\_\_\_  
 Remarks \_\_\_\_\_  
Hay - Contr.  
 Spudding Date \_\_\_\_\_

Drig. Data \_\_\_\_\_ Monaghan Pool  
Location

J. G. McGEHEE