


Decatur

KANSAS

SECTION 20 TOWNSHIP 2 RANGE 28 WWELL NO. #1 BurnsCOMPANY Empire Drlg.

NORTH

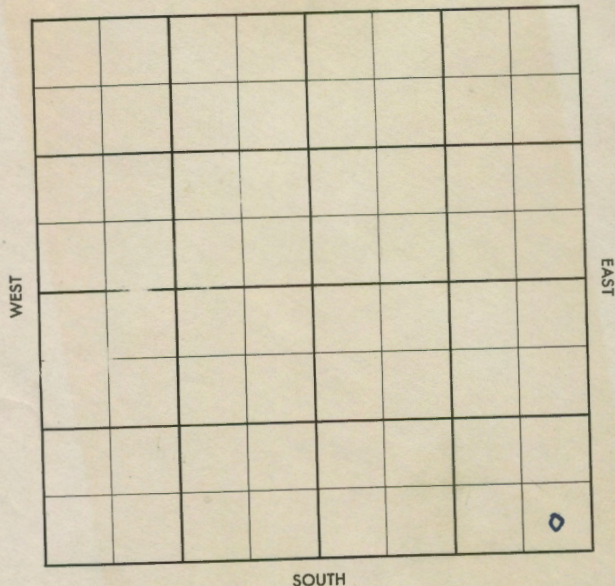

SOUTH

16

Decatur

KANSAS

SEC. 20 TWP. 2 R. 28W

WELL NO.

#1 Burns

FARM

COMPANY

Empire Drlg

CONTRACTOR

Co Tools

Semi Wildcat


Ft. from N. Line

Ft. from S. Line

Ft. from E. Line

Ft. from W. Line

NORTH

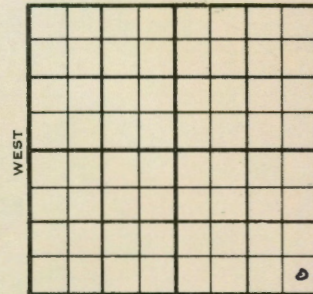

SOUTH

SE

SE SE SE

	ELEVATION	REPORT
1955	2528'	
11/16	Comm 11/12/55 8" @ 163/115 Drlg 2430	
11-23	DST 3526-42 op 30 min. rec. 15' mud 0/30" DST 3541-60 op 1 hr. rec. 80' swm 1130/30" DST 3610-38 op 1 hr. rec. 65' mud, 840/30" D & A Tops: Anh. 2217 H. 3472 L. 3513 B.K.C 3714 T.D. 3722'	
		ABANDONED

County	Decatur		Elev.	
Sec.	20	Twp.	2	Rgs.
Company	Empire Drilg.			
Farm Name	Burns		No.	1

TOPS	DEPTH	LOG	DATUM	Loc. in Sec.
Anh.	2217			SE SE SE
Tr.				
H.				
Tr.				
Dg.				
BL.				
L.				
K.C.				Geol.
B.K.C.				Contr.
Ce.				Co. tools
C.				
M.				Pool
M.				Semi Wildcat
K.				
Mz.				
Me.				
V.				
S.				
S.				
A.				
R.				
Pe.				
G.				
T.D.				

Date Comm. 11-12-55 NOV 19 1955

8" @ 163/115 drlg. 2430 NOV 16 1955

FIRST REPORT

County	Decatur		Elev.	2528
Sec.	20	Twp.	2	Rgs.
Company	Empire Drilg.			
Farm Name	Burns		No.	1

TOPS	DEPTH	LOG	DATUM	Loc. in Sec.
Anh.	2217			SE SE SE
Tr.				
H.	3472		944	
Tr.				
Dg.				
BL.				
L.	3513		985	
K.C.				Geol.
B.K.C.	3714		1186	Contr.
Ce.				Co. tools
C.				
M.				Pool
M.				Semi Wildcat
K.				
Mz.				
Me.				
V.				
S.				
S.				
A.				
R.				
Pe.				
G.				
T.D.	3722			

Date Comm. 11-12-55 NOV 23 1955

8" @ 163/115 DST 3526-42 open 30 min.

rec. 15' mud 0/30" DST 3541-60

open 1 hr. rec. 80' swm 1130/30"

DST 3610-38 open 1 hr. rec. 65' mud

810/30"

D & A

ABANDONED