


KANSAS


Section 27 Township 2 Range 28 W
Well No. # 1 Stoney
Company Sauvage & Dunn

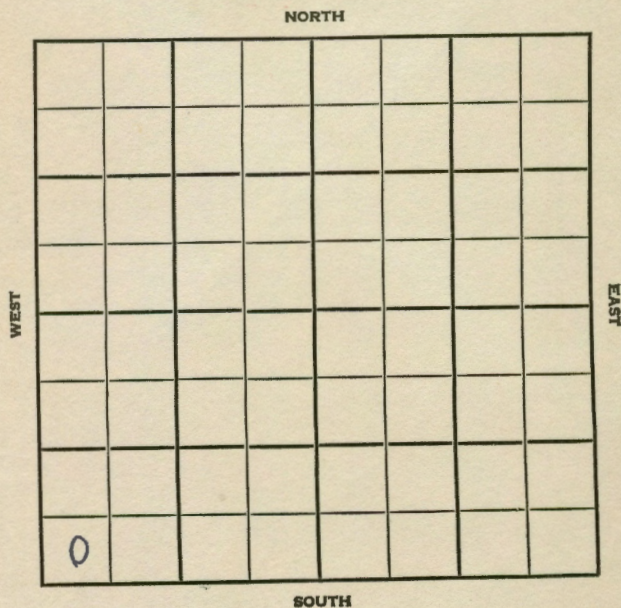

13

SEC.	27	TWP.	2	R.	28W
WELL NO.					
#1 Stoney					
FARM					
COMPANY					
Sauvage & Dunn					
CONTRACTOR					
Co. Tools.					
Wildcat.					

_____ Ft. from N. Line
330 _____ Ft. from S. Line
_____ Ft. from E. Line
330 _____ Ft. from W. Line

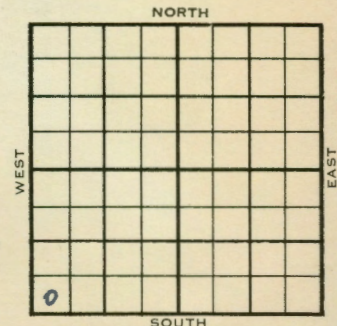

SW SW SW
Ohio - ACP Lion - ACP & DHM

1955	ELEVATION 2638	REPORT
------	-------------------	--------

3/16	Cellar & Pits
------	---------------

9/14	Comm 3-22-55
H	3591
Tr	3619
L	3632
TD	3749

8" @ 190 w/130; DST 3650-62 op 30"
St blo thru out, rec 120' HOCM, 112'
cl oil now BHP 1200# 20"; DST 3708-
15 op 1 hr rec 170' SW, SSO, BHP
1250#; RTD 3749; 5" 3738; CO;
24/3658-62; fill 1380' oil, 50' sw
1 hr fill 2800' fluid 16 hrs; pmp
5 bopk 8 hrs pmp 74 bo in 12 hrs
pmp 15 to 18 bo plus 3 bwpd;
pmp 12 bo plus 1 bwpd

COMPLETED


County **Decatur** Elev. **2638**
 Sec. **27** Twp. **2** Rge. **28W**
 Company **Sauvage & Dunn**
 Farm Name **Stoney** No. **1**

TOPS	DEPTH	LOG	DATUM	Loc. in Sec.
Anh.				SW SW SW
Tp.	3591		953	DS - SW & S ¹ / ₂ NW
H.	3619		981	Ohio-ACP
Tr.				Lion-ACP DHM
Dg.				Geol.
Bl.	3632		994	Contr.
L.				
K.C.				
B.K.C.				
Ce.				
C.				
M.				
M.				Pool
K.				Vorn E.
Mz.				
Mo.				
V.				
S.				
S.				
A.				
R.				
Pc.				
G.				
TD	3749			

Date Comm. **3-22-55** SEP 14 1955

8" 190 w/130; DST 3650-62 op 30" st blo
 thru out, rec. 120' hocm, 112' cl oil now
 BHP 1200# 20"; DST 3708-15 op 1 hr. rec.
 170' sw, sso, BHP 1250#; RTD 3749; 5" 3738;
 CO; 24/3658-62; fill 1380' oil, 50' sw 1 hr.;
 fill 2800' fluid 16 hrs.; pmp 5 boph 8 hrs.
 pmp 74 bo in 12 hrs.; pmp 15 to 18 bo plus
 3 bwpd; pmp 12 bo plus 1 bwpd

County **Decatur** State **Kansas**
 Sec. **27** (Blk.) **2** (Sur.) **28W** Map No.
 Operator **Sauvage & Dunn**
 Well No. **1** Farm **Stoney**
 Elev. Location **SW SW SW**

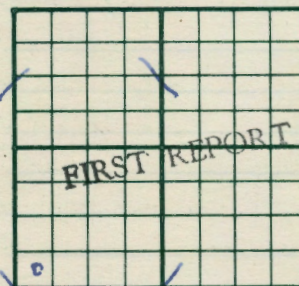

330 Ft. From **S** Line **SW**
330 Ft. From **W** Line **Quarte**
 1st. Report **MAR 16 1955**
 Completion
 Remarks **Ohio - ACP**
Lion - ACP & DHM
Co. tools
 Spudding Date

Drig. Data **Wildcat**

Cellar & pits

FABEN GILSTRAP