

Decatur


KANSAS

SECTION 27 TOWNSHIP 2 RANGE 28 W

WELL NO. #2 Stoney

COMPANY Sauvage & Dunn

NORTH SE SW SW
NW NW SW

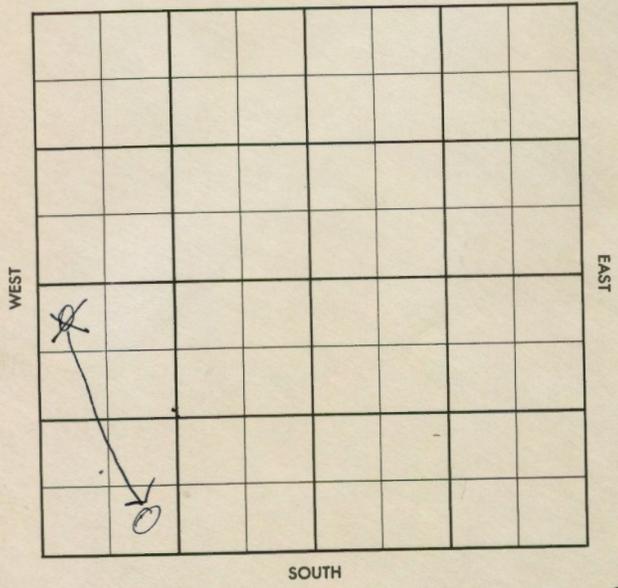

13

FORM 513 SUNRAY

County Decatur Elev. 2850
 Sec. 27 Twp. 2 Rge. 28
 Company Sauvage & Dunn
 Farm Name Stoney No. 2

TOPS	DEPTH	LOG	DATUM	Loc. in Sec.
Anh.				NW NW SW
TP.				
H.				
Tr.				
Dg.				
Bl.				
L.				Geol.
K.C.				Contr.
B.K.C.				
Ce.				
C.				
M.				Pool
M.				
Kz.				
Mz.				
Mo.				
V.				
S.				
S.				
A.				
R.				
PE.				
G.				
T.D.				

FIRST REPORT
 MAR 5 57

Date Comm. 3-2-57
8 5/8" @ 165, Drlg. 2700

~~33~~

225' SACM BHT 870/15 DST
 3698-3730 up 30" rec 50' Md
 (550) 390/20" 5 1/2 @ 3794/125
 MAR 27 '57 ✓ APR 3 '57 Co 3756 24/3722
 -28 no rec 16/3679-83 13
 \$ 1 Boph 16/3640-44 tst
 3 Boph 8 hrs T & R APR 10 '57 ✓
 APR 17 '57 APR 24 '57 MAY 1 '57 B '57 WOPOT
 MAY 15 '57 MAY 22 '57 MAY 29 '57 Ph P. 139
 Bopd + 100 wts gran 34°

27-2-28

SE SW SW

CORRECTION

2614 Ge
2617 DF

County ~~Decatur~~ Elev. ~~2850~~ 26231
 Sec. ~~27~~ Twp. 2 Rge. 28
 Company Sauvage & Dunn
 Farm Name Stoney No. 2

	TOPS	DEPTH	LOG	DATUM	Loc. in Sec.
Anh.		2305			NW-NW-SW SE SW SW
Tp.	3404	3378			
H.	3567	3567			
Tr.		3596			
Dg.					
Bl.					
L.		3610			Geol.
K.C.					
B.K.C.					Contr.
Ce.					
C.					
M.					
M.					Pool
K.					
Mz.					
Ma.					
V.					
S.					
S.					
A.					
R.					
Pe.					
G.					
T.D.		3820			

COMPLETE
 MAY 29 '57

Date Comm. 3-2-57
 8 5/8" @ 185, Drlg. 2700 MAR 13 '57

RTP ~~3778~~ 5 1/2" ~~3778~~ / 1000
 WOC MAR 20 '57 DST 3626-42 up 1 hr
 rec 840' 9554 oil + 30' SCM 968/20
 DST 3642-60 up 1 hr rec 20' Md
 330/20 DST 3657-3700 up 11" rec

No. Sec. T. R.