


Section 29 Township 2 Range 28W

Well No. #1 Jorn

Company W. W. Sauvage

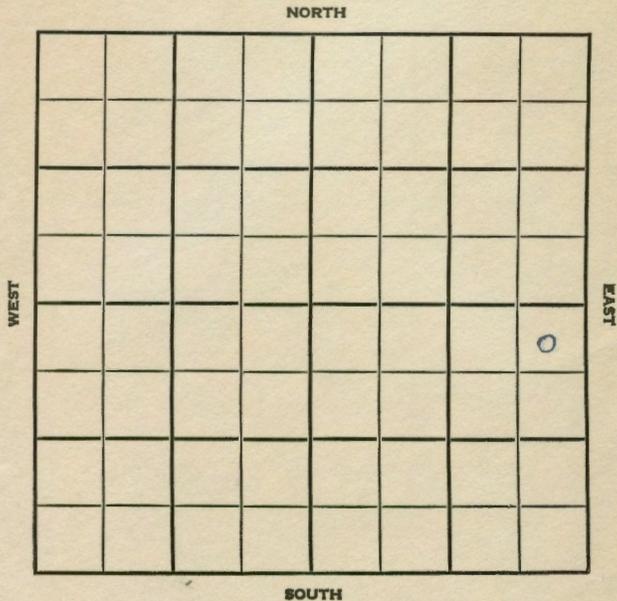

9

SEC.	TWP.	R.
29	2	28W

WELL NO. 1 Jorn FARM

COMPANY W. W. Sauvage


CONTRACTOR Co. Tools Wildcat

330 Ft. from N. Line

Ft. from S. Line

330 Ft. from E. Line

Ft. from W. Line

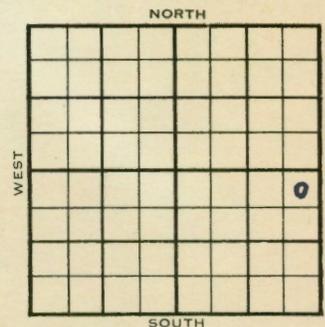

NE NE SE
Max Cohen DHM - APCO - Ac & DHM

	ELEVATION	REPORT
1954	2547'	

11/3 8" @ 125'
D rlg. 2860'

1955
2/23 Oil Well
TD 3745'
8" @ 125'
DST 3559'-73' opn 1 hr, rec 280' gas,
92' oil, 1050#
DST 3574'-90' opn 1 hr, rec 70' socm
1230# Top 3329', Heeb 3499', Lans
3542' B KC 3737'
TD 3745'
5" @ 3685'
Perf 3567-71 S/ 1 boph 20/ 3577-83
SP 3574' 10/ 3568-70 P/ 8 bopd. 300 A
P/ 12 to 13 bopd. 500 A
Comp 15 bopd.

COMPLETED

County Decatur State Kansas
 Sec. 29 (Blk. 2) (Sur. 28W) Map No.
 Operator W. W. Sauvage
 Well No. 1 Farm Jorn
 Elev. 2547 Location NE NE SE

330 Ft. From N Line SE
 330 Ft. From E Line Quarter
 Ist. Report
 Completion FEB 23 1955
 Remarks Jorn Pool
Co. tools
 Spudding Date

Drlg. Data Oil well TD 3745
8" @ 125 ~~125~~ DST 3559-73
open 1 hr. Rec. 280' gas 92' oil 1050#
DST 3574-90 open 1 hr. Rec. 70' socm
1240# Top. 3329 Heeb. 3499 Lans. 3542
B KC 3737 TD 3745 5" @ 3685
perf/ 3567-71 S/ 1 boph 20/ 3577-83
SP 3574 10/ 3568-70 P/ 8 bopd 300 A
P/ 12 to 13 bopd 500 A
Comp. 15 bopd

FABEN GILSTRAP

County Decatur State Kansas
 Sec. 29 (Blk. 2) (Sur. 28W) Map No.
 Operator W. W. Sauvage
 Well No. 1 Farm Jorn
 Elev. Location NE NE SE

330 Ft. From N Line SE
 330 Ft. From E Line Quarter
 Ist. Report NOV 3 1954
 Completion Max Cohen - DFM
 Remarks ABCO - AC & DFM
Co. tools
 Spudding Date

Drlg. Data Wildcat
8" @ 125 drlg. 2860

FABEN GILSTRAP