

Decatur

KANSAS


SECTION 34 TOWNSHIP 2 RANGE 28

WELL NO. #1 Beck

COMPANY Sauvage & Dunn

C NE NW

NORTH ~~NE NW NW~~

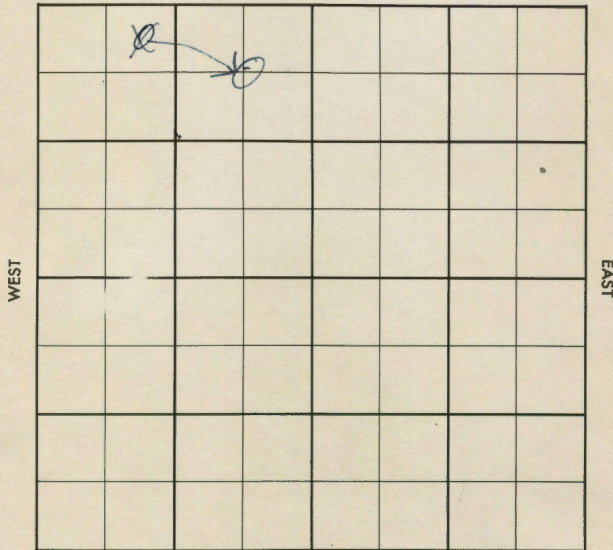

3

