

KANSAS

Decatur

Sec. 16 Twp. 2 R. 29-W

Well No. #1 Finis Penn Estate Farm

Helmerich & Payne Company


Wildcat

330 Ft. from N. Line

Ft. from S. Line

Ft. from E. Line

330 Ft. from W. Line

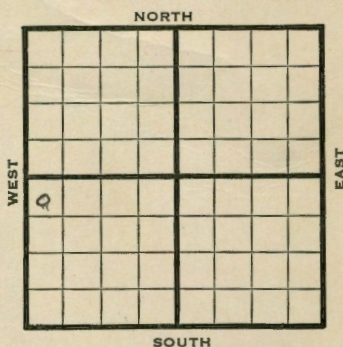

1943

REPORT

3/31

Location

4/7

8" @ 207'

Drlg. 2045'

4/14

Anhy 2435

Drlg. 3580'

4/21

Lans 3752

SO 3752-53

BKC 3951

Viola 4174

Arb 4207

Drlg. 4263 No show

4/28

Arb. 4207

T.D. 4303'

No shows.

ABANDONED

KANSAS


Decatur

FORM 51 5M 1-42 PETROL

Section 16 Township 2 Range 29-W

Well No. #1 Finis Penn Estate

Company Helmerich & Payne

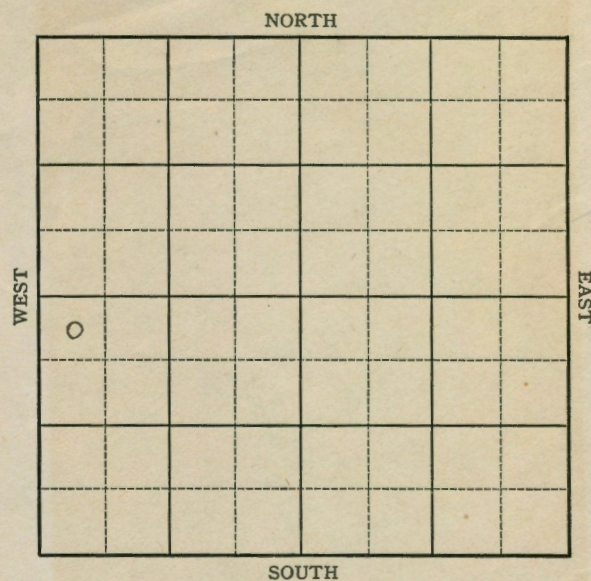

12

Decatur

KANSAS
 Map No. 111 Sec. 16 Twp. 2 R. 29W

Well No. 1 Finis Penn Estate

Helmerich & Payne

Company

ABANDONED

Contractor

NW SW

SECTION PLAT

330 Ft. from N. Line

Ft. from S. Line

Ft. from E. Line

330 Ft. from W. Line

WILDCAT

Location

RECORD

Cased in., ft.

Sand

Gas

Oil

Total Depth 4309

PRODUCTION

1st 24 hrs. Nat.

1st 24 hrs. after shot

Gas Cu. Ft.

Dry Hole

Abandoned

Date

APR 28 1943 19

S. J. LEWIS Scout

Decatur

KANSAS
 Map No. 111 Sec. 16 Twp. 2 R. 29W

Well No. 1 Finis Penn Estate

Helmerich & Payne

Company

FIRST REPORT

Contractor

NW SW

SECTION PLAT

330 Ft. from N. Line

Ft. from S. Line

Ft. from E. Line

330 Ft. from W. Line

WILDCAT

Location XXX

RECORD

Rig up

Drilling and Remarks:

Cased in., ft.

Sand

Gas

Oil

Total Depth

PRODUCTION

1st 24 hrs. Nat.

1st 24 hrs. after shot

Gas Cu. Ft.

Dry Hole

Abandoned

Date

MAR 31 1943

19

S. J. LEWIS Scout