


SECTION 20 TOWNSHIP 2 RANGE 29W

WELL NO. #1 Scott

COMPANY Jones, Shelburne & Farmer

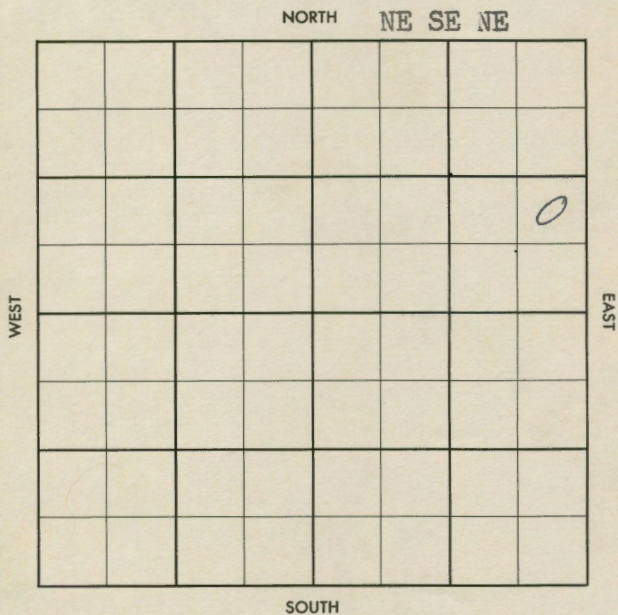

8

FORM 513 SUNRAY

County ~~Decatur~~ Elev. 2666  
 Sec. 20 Twp. 2 Rge. 29W  
 Company Jones, Shelburne & Farmer  
 FarmName Scott No. 1

TOPS	DEPTH	LOG	DATUM	Loc. in Sec.
Anh. <i>How</i>	3482			NE S E NE
TP.	3499	3478		
H.	3699	3639		
Tr.		3674		
Dg.				
Bl.				
L.	3682	3684		Geol.
K.C.				Contr.
B.K.C.		3911		
Ce.		4145		
C.				
M.				
M.				
K.				Pool
Mz.				Wildcat
Me.				
V.				
S.				
S.				
A.		4171		
R.				
PE.				
G.				
TD.	4220			

Date Comm. Phillips - DHM  
 Location MAY 15 57 5-13-57 85/8  
 165/135 @ 186 MAY 22 57 PST  
 3696-3725 1hr 20' 50 CM  
 BHP 0 PST 3782-3816 1hr  
 55' Md 1280/20" @ 3991  
 MAY 29 57

*D.S.*

3B-M

# WILDCAT

FORM 513 SUNRAY

County ~~Decatur~~ Elev. 2666  
 Sec. 20 Twp. 2 Rge. 29W  
 Company Jones, Shelburne & Farmer  
 FarmName Scott No. 1

TOPS	DEPTH	LOG	DATUM	Loc. in Sec.
Anh.				NE S E NE
TP.				
H.				
Tr.				
Dg.				
Bl.				
L.				Geol.
K.C.				Contr.
B.K.C.				
Ce.				
C.				
M.				
M.				Pool
K.				Wildcat
Mz.				
Me.				
V.				
S.				
S.				
A.				
R.				
PE.				
G.				
TD.				FIRST REPORT

Date Comm. Phillips - DHM  
 Location

~~33~~

~~X~~