

Decatur

KANSAS


KANSAS

SECTION 27 TOWNSHIP 2 RANGE 29W

WELL NO. #1 Dowdall

COMPANY W. W. Sauvage

NORTH

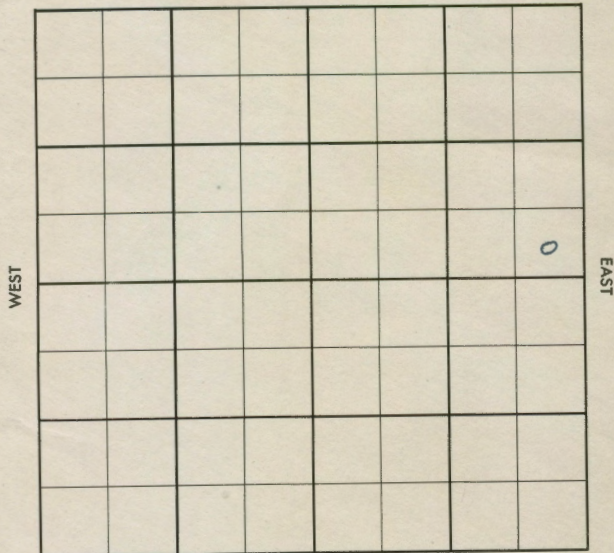

SOUTH

8

SEC. 27 TWP. 2 R. 29W

WELL NO.

#1 Dowdall

FARM

COMPANY

W.W. Sauvage

CONTRACTOR

Co. Tools

WILDCAT


Ft. from N. Line

Ft. from S. Line

Ft. from E. Line

Ft. from W. Line

SE SE NE

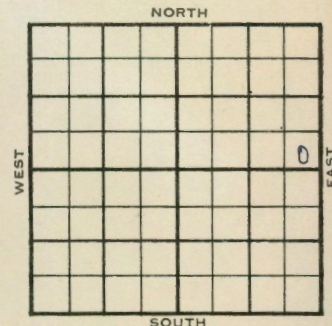

Gulf - ACP

1956

ELEVATION

2694 RB, 2691 DF

REPORT

4-25

MIR

5-9

Comm. 4-27-56

8 5/8" @ 183

DST 3716-82 op 90 min. rec. 295' MSW,

BHP 1000/20"

D & A

H. 3677', L. 3719', A. 4171'.

TD 4225'

ABANDONED

County Decatur Elev. 2694 RA
 Sec. 27 Twp. 2 Rge. 29W
 Company W. W. Sauvage
 FarmName Dowdall No. 1

TOPS	DEPTH	LOG	DATUM	Loc. in Sec.
Anh.				SE SE NE
Tr.	3677			
Dg.				
BL.	3719			
L.				
K.C.				
B.K.C.				
Ce.				
C.				
M.				
K.				
Mz.				
Me.				
V.				
S.				
S.				
A.	4171			
R.				
Pe.				
G.				
TD.	4225			

Geol. _____
 Contr. _____
 Co. tools _____
 Pool _____
 Wildcat _____

MAY 9 1956
 0
 ABANDONED

Date Comm. Gulf - AcP
M I R MAY 2 '56 4-27-56 85/8
183 3720 DST 3716-82
90" rec. 295' MSW BHP 1000/20"
3782 MAY 9 '56

D&A

County Decatur Elev. _____
 Sec. 27 Twp. 2 Rge. 29W
 Company W. W. Sauvage
 FarmName Dowdall No. 1

TOPS	DEPTH	LOG	DATUM	Loc. in Sec.
Anh.				SE SE NE
Tr.				
H.				
Tr.				
Dg.				
BL.				
L.				
K.C.				
B.K.C.				
Ce.				
C.				
M.				
M.				
K.				
Mz.				
Me.				
V.				
S.				
S.				
A.				
R.				
Pe.				
G.				
TD.				

Geol. _____
 Contr. _____
 Co. tools _____
 Pool _____
 Wildcat _____

FIRST REPORT
 APR 25 '56

Date Comm. Gulf - AcP
M I R

8301 S YAM
 5.9