


Section 31 Township 2 Range 29 W

Well No. # 1 Pollnow

Company Sauvage & Dunn Drlg.

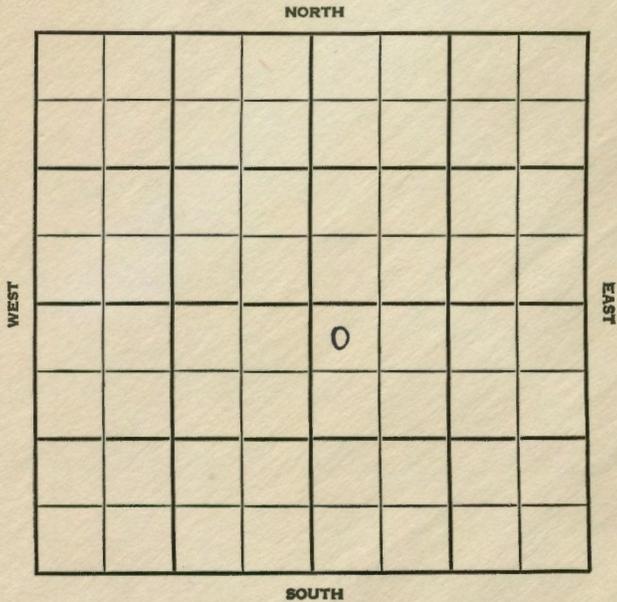

10

SEC.	TWP.	R.
31	2	29 W

WELL NO. # 1 Pollnow FARM

COMPANY Sauvage & Dunn Drlg.

CONTRACTOR Co. Tools


Wildcat

330 Ft. from N. Line

_____ Ft. from S. Line

_____ Ft. from E. Line

330 Ft. from W. Line

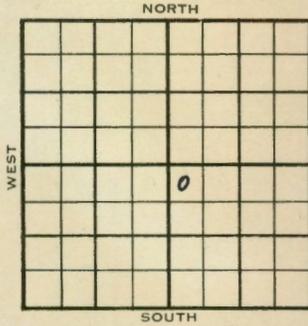

NW NW SE
 PEPL - FO
 Franco-Central support

1954	ELEVATION 2758'	REPORT
------	---------------------------	--------

8/11 Location

10/20 Spud 8-16-54
 D&A
 TD 3989'
 8" @ 215'
Heeb 3728', Tor 3759', Lans 3772'
 DST 3764-80', opn 1 hr., rec. 180'
 HOCM, 60' wtr, 1250#
 DST 3793-3805', opn 1 hr., rec. 54'
 muddy oil, 225#
 DST 3830-3902', opn 1 hr., rec. 72'
 mud, 1175#
 TD 3989'
 5" @ 3843'
 CO to 3775'
 3/3764-65, CO to 3815
 25/3800-04, B/15 bo 8 hrs., 1000A
 FU 400' fluid
 /12 bo 15 bw
 CO to 3815, 6/3803-05, 10 to 12 gop
 1000A, 6/3803-05, 1000A
 30/3760-70
 FU 300' acid cut SW, VSSO,
 TD 3989'
 D&A

ABANDONED

