


Section 11 Township 2 Range 30W

Well No. #1 Mines

Company Musgrove Pet.

NORTH

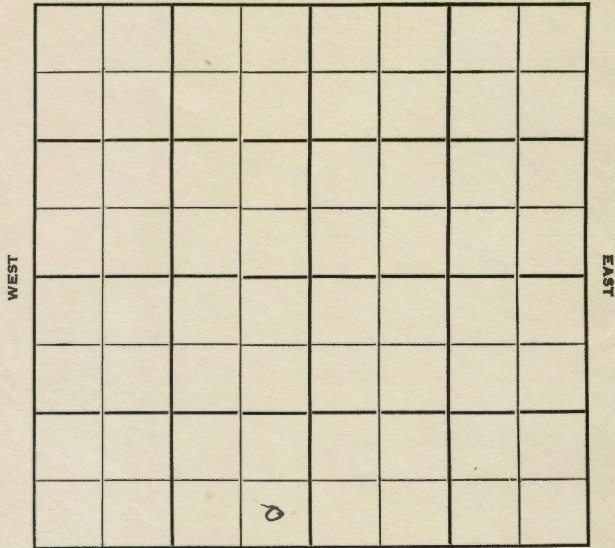

SOUTH

14

Sec. 11 Twp. 2 R. 30W

Well No. #1 Mines Farm

Musgrove Pet. Company

Musgrove Contr. Contractor

Wildcat


..... Ft. from N. Line

330' Ft. from S. Line

330' Ft. from E. Line

..... Ft. from W. Line

NORTH

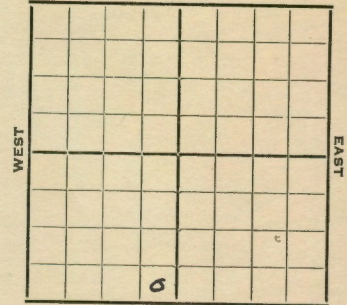

SOUTH

SE SE SW

1952 **Elev. 2772'** REPORT

3/19 Location  
 3/25 8" @ 246'  
 Drlg. 1630'  
 4/1 Drlg. 2900'  
 4/9 **Heeb. 3717** **Lans. 3751**  
 SSO 3751-56  
 DST 3753-3801, 1 hr. 20' m  
 470# **BKC 3981** **Cong. 4150**  
**Arb. 4266**  
 Drlg. 4284'

4/16 Spud 3-20-52  
 D & A TD 4320' 8" @ 246  
**Heeb 3717'** **Lans. 3751'** **SSO 3751-56'**  
 DST 3753-3801 open 1 hr. rec 20' mud  
**B KC 3981'** **Cong. 4150'** **Arb. 4266'**  
 TD 4320'  
 D & A

**ABANDONED**

