


SECTION 14 TOWNSHIP 2 RANGE 30W

WELL NO. #1 Jording

COMPANY Jones, Shelburne & Farmer

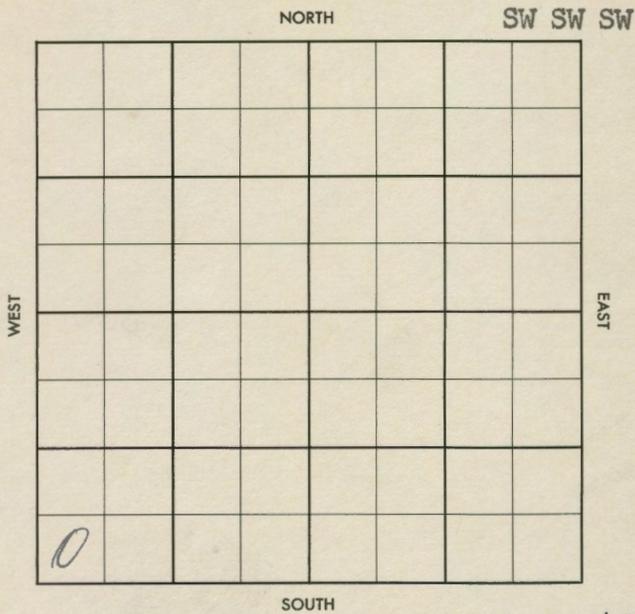

SEC. 14 TWP. 2 S R. 30 W

WELL NO. # 1 Jording FARM

COMPANY Jones, Shelburne & Farmer

CONTRACTOR

Wildcat


\_\_\_\_\_ FT. FROM N. LINE

\_\_\_\_\_ FT. FROM S. LINE

\_\_\_\_\_ FT. FROM E. LINE

\_\_\_\_\_ FT. FROM W. LINE

SW SW SW

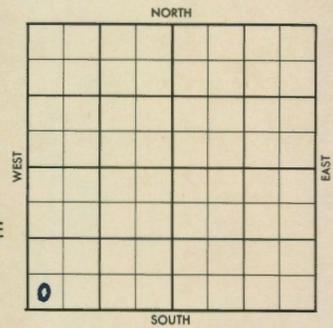

SDX-3/4 Mile Phillips-DHM

	ELEVATION	REPORT
1957	2798'	

5/8	Location	(FR Tkt)
-----	----------	----------

# WILDCAT

FORM 513 SUNRAY

County Decatur Elev. 2798  
Sec. 14 Twp. 2 Rge. 30W  
Company Jones, Shelburne & Farmer  
Farm Name Jording No. 1

TOPS	DEPTH	LOG	DATUM	Loc. in Sec.
Anh.				SW SW SW
Tr.				
H.				
Tr.				
Dg.				
Bl.				
L.				Geol.
K.C.				Contr.
B.K.C.				
Cc.				
C.				
M.				Pool
K.				Wildcat
Mz.				
Me.				
V.				
S.				
S.				
A.				
R.				
Pe.				
G.				
T.D.				

FIRST REPORT  
SDX -  $\frac{3}{4}$  mile  
MAY 8 '57

Date Comm. Phillips - DHM  
Location \_\_\_\_\_

~~33~~

REV. 10 1951  
J.M.M.

new oil in 16 hrs JUL 3 '57 ✓ JUL 10 '57  
 + 8% wta Pop JUL 17 '57 P. 72  
 Bopd + 8% wta. JUL 24 '57 JUL 31 '57  
 decreased to 12 Bopd + lots  
 wta. To rework. AUG 8 '57 AUG 14 '57  
 AUG 21 '57 AUG 28 '57 SEP 4 '57 Decline to P.  
 5 Bopd 8% wta

DDA

14-2-30w

swan sw

County **Decatur** Elev. **2798**  
 Sec. **14** Twp. **2** Rge. **30W**  
 Jones, Shelburne & Farmer  
 Jording No. **1**

TOPS	DEPTH	LOG	DATUM	Loc. in Sec.
Ans.				SW SW SW
Tp. <i>How</i>	3574			
H. <i>TP</i>	3592			
Tr. <i>H<sub>2</sub></i>	3735			
Dg. <i>TR</i>	3775			
Bl.				
L.	3785			
K.C.				Geol.
B.K.C.	4022			Contr.
Ce.				
C.				
M.				
M.				
K.				
Mz.				Wildcat
Me.				
V.				
S.				
S.				
A.	4291			
R.				
PC.				
G.				
TD.	4326			

Jording disc Pool

~~3~~  
4 mile  
ABANDONED

Date Comm. Phillips - DHM  
 Location MAY 15 '57 ✓ MAY 22 '57 ✓ MAY 29 '57  
 5-23-57 8578 218150 M  
 3070 JUN 5 '57 DST 3880-3918 1h  
 1' Md. BHP 6/20" DST 3939-65  
 1hr 180' Free oil + 30' Mdy oil  
 PPO-110 BHP 120 5 1/2 4000 /  
 50 21 JUN 12 '57 WOCT JUN 19 '57 JUN 26 '57  
 MICT PF 3941-46 B 25 Goph  
 + 5 GMW 12 1/2 \$ 6d + 86 B