


WELL RECORD

4-2-32W

(Mail to Kansas Geological Survey, 4150 Monroe Street, Wichita, Kansas 67209)

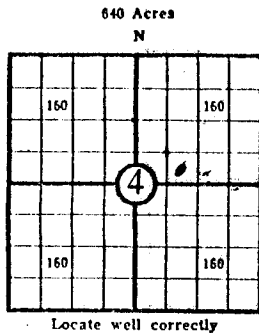

Lease Name: GOELTL Well No. 1
 Well Located: SE SW NW
 Rawlins County SEC 4 TWP 2 RGE 32W
 Operator: Chief Drilling Co., Inc.
 Address: 905 Century Plaza
 Elevation: Ground 2903 D.F. 2905 K.B. 2908
 Type Well: (Oil, gas, dry hole) Dry Hole

Drilling Commenced: 11/26 1971 Drilling Completed: 12/5 1971
 Well Completed: 12/5 1971 Total Depth 4075'
 Initial Production: _____

Casing Record

Size: 8 5/8" OD Set at 276' Size: _____ Set at _____
 Size: _____ Set at _____ Size: _____ Set at _____

Liner Record

Size: _____ Set from _____ To _____

Cementing

Casing Size	Sacks	Type Cement and Additives
<u>8 5/8" OD</u>	<u>175 Sks</u>	<u>Common Quick Set</u>
_____	_____	_____
_____	_____	_____

Perforations

Formation	Perforated Interval and Number Shots
_____	_____
_____	_____
_____	_____
_____	_____

Electric Log Run (Show type log and depths covered)

CONFIDENTIAL

Cont. 4-2-32w

Show Drill Stem Tests,
Well Stimulation and
Production Tests


Formation Top Bottom

Anhydrite	2654	2692
Oread	3766	
Lansing K.C.	3814	4064
R.T.D.	4075	

DST #1 3784 - 3875'
Top and 50' zones
Open 45 min.
Rec. 15' mud with specks of oil
IBHP 130# 20 min.
FBHP 90# 20 min.
FP 65 -65#

DST #2 3875 - 3960'
100 - 140' zones
Open 50 min.
Rec. 10' very slightly oil cut mud
IBHP 244# 20 min.
FBHP 170# 20 min.
FP 55 - 65#

DST #3 3958 - 4075'
Open 45 min.
Rec. 18' mud
IBHP 685# 20 min.
FBHP 710# 25 min.
FP 85 -90#

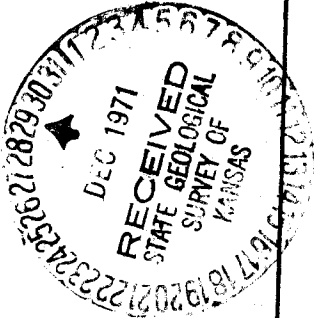

SMP TOPS	DEPTH
ANHY	2654
B ANHY	2692
Oread	3766
LKC	3814
BKC	4064
RTD	4075

297231

4-2-32w