

Kingman

DX 78-1


KANSAS

Section 1 Township 30 Range 10W

Well No. #1 Carter

Company Jones, Shelburne & Farmer

NORTH

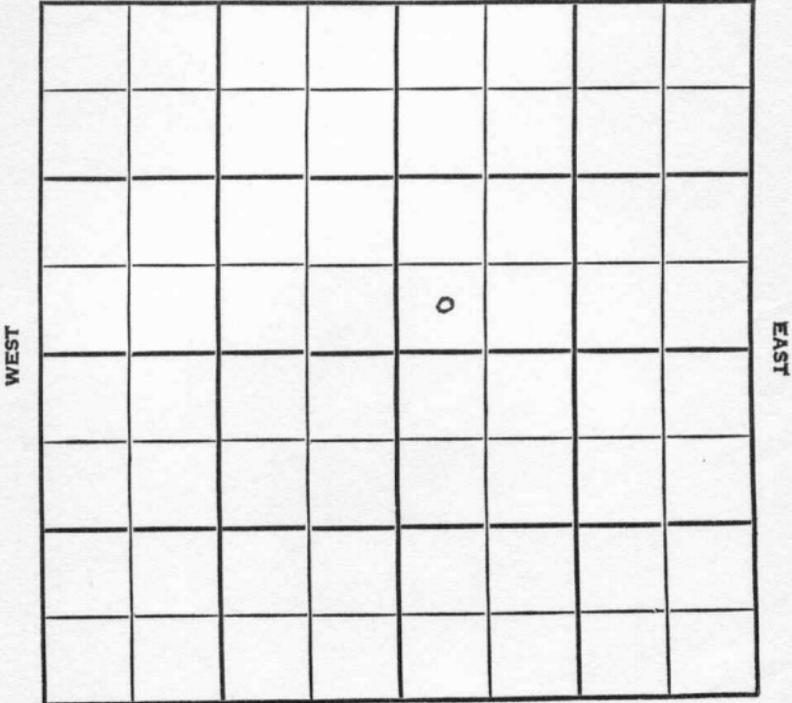

SOUTH

WEST

EAST

Kingman

KANSAS


SEC. 1	TWP. 30	R. 10W
-----------	------------	-----------

WELL NO. _____
 #1 Carter FARM
 COMPANY _____

Jones, Shelburne & Farmer
 CONTRACTOR _____
 Co. Tools.

Wildcat.

_____ Ft. from N. Line
 330 _____ Ft. from S. Line
 _____ Ft. from E. Line
 330 _____ Ft. from W. Line

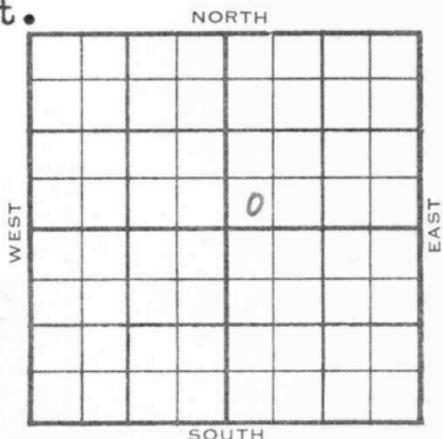

SW SW NE

	ELEVATION	REPORT
1955	1681'	

4/6 Spud 4-2-55
 8" @ 321'
 Drlg. 1575'

4/27 Spud 4-2-55 D & A TD 4693'
 8" @ 321' Heeb 3423' Doug 3467'
 Lans 3650' Miss 4245'
 DST 4246-52 open 1 hr rec 30' GCM
 170# Viola 4511'
 DST 4511-19, open 1 hr rec 10' mud.
 100# Simp. 4574' Arb. 4679'
 TD 4693' D & A

ABANDONED

County Kingman State Kansas
 Sec. 1 (Blk.) (Twp.) 30 (Sur.) (Rge. 10W) Map No.
 Operator Jones, Shelburne & Farmer
 Well No. 1 Farm Carter
 Elev. 1681 Location SW SW NE



330 Ft. From S Line NE
330 Ft. From W Line Quarter
 1st. Report
 Completion APR 27 1955
 Remarks Wildcat
Co. tools
 Spudding Date 4-2-55

Drlg. Data D & A TD 4693
8" @ 321 Heeb. 3423 Doug. 3467
Lans. 3650 Miss. 4245 DST 4246-52
open 1 hr. Rec. 30' gcm 170#
Viola 4511 DST 4511-19 open 1 hr.
Rec. 10' mud 100# Simp. 4574
Arb. 4679 TD 4693
D & A

FABEN GILSTRAP