

KANSAS

Kingman County

FORM 51 5M PETROL

Section 1 Township 30 Range 10W

Well No. 1 Carter

Company B & R & Gore

NORTH

							0

SOUTH

WEST

EAST

KANSAS

Kingman County

Sec. 1 Twp. 30 R. 10W

Well No. 1 Carter Farm

B & R & Gore Company

Wildcat


330 Ft. from N. Line

         Ft. from S. Line

330 Ft. from E. Line

         Ft. from W. Line

NE/c Elev. 1660

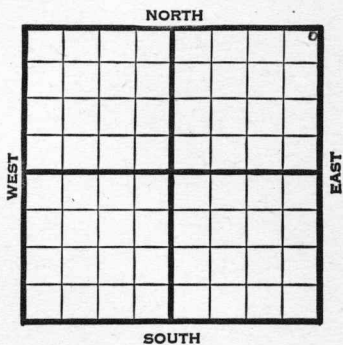

1945

REPORT

5/9	Location
5/17	"
5/24	Drlg. 700'
5/31	Drlg. 3110'
6/13	Viola 4477
	Arb 4648
	TD 4698'
	<b>ABANDONED</b>

Kansas Pool Name WildcatMap No. 54 Sec. 1 Twp. 30 R. 10WWell No. 1 CarterB & R & Gore

Company

FIRST REPORT

Contractor

NE/c

## SECTION PLAT

330

Ft. from N. Line

Ft. from S. Line

330

Ft. from E. Line

Ft. from W. Line

			0

Kingman CountyLocation X

Rig up

Drilling and Remarks:

## RECORD

Cased \_\_\_\_\_ in., \_\_\_\_\_ ft.

Sand \_\_\_\_\_

Gas \_\_\_\_\_

Oil \_\_\_\_\_

Total Depth \_\_\_\_\_

## PRODUCTION

1st 24 hrs. Nat. \_\_\_\_\_

1st 24 hrs. after shot \_\_\_\_\_

Gas \_\_\_\_\_ Cu. Ft.

Dry Hole \_\_\_\_\_

Abandoned \_\_\_\_\_

Date

MAY 9 1945 19S. J. LEWIS

Scout

Kansas Pool Name WildcatMap No. 54 Sec. 1 Twp. 30 R. 10WWell No. 1 CarterB & R Gore CompanyABANDONED Contractor  
NE/c E1/660

## SECTION PLAT

330 Ft. from N. Line       Ft. from S. Line330 Ft. from E. Line       Ft. from W. Line

			0

Kingman County

Location                     Rig up                     

Drilling and Remarks:

Viol 4477Cr 4648

## RECORD

Cased            in.,            ft.Sand                     Gas                     Oil                     Total Depth 4698

## PRODUCTION

1st 24 hrs. Nat.                     1st 24 hrs. after shot                     Gas                      Cu. Ft.Dry Hole                     Abandoned                     

Date

JUN 13 1945 19 S. J. LEWIS Scout