


Section 1 Township 30 Range 9W

Well No. #1 Adelhart.

Company Rupp-Ferguson

NORTH

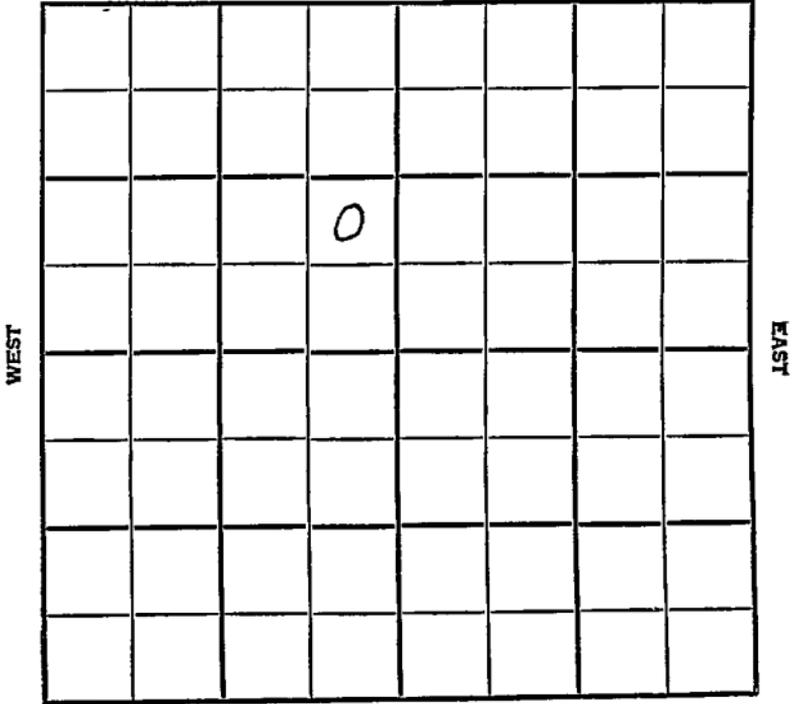

SOUTH


SEC.	TWP.	R.
1	30	9W

WELL NO. #1 Adelhart. FARM

COMPANY Rupp-Ferguson

CONTRACTOR Co. Tools.
Zenda Ext.

_____ Ft. from N. Line
990 _____ Ft. from S. Line
330 _____ Ft. from E. Line
_____ Ft. from W. Line

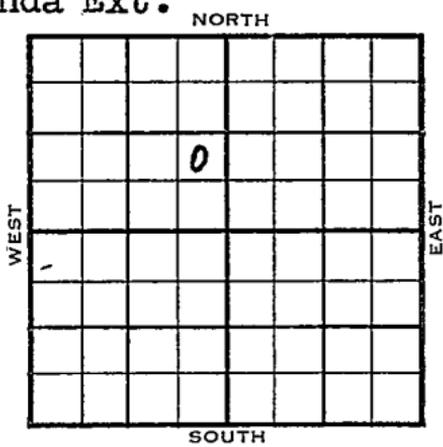

NE SE NW
Magnolia - DHM

1955	ELEVATION 1551'	REPORT
------	--------------------	--------

4/6

Spud 4-1-55
8" @ 273'
Drlg. 2700'

4/20

Spud 4-1-55 D & A TD 4230'
8" @ 273 Doug 3303 Lans 3465
Miss 4177'
DST 4179-85 open 2 hr rec 445' gas,
24' GCM, 31' GCMW 430#
DST 4185-4206, open 1 1/2 hr rec 57' GCM
62' SGCSW 730# TD 4230'
IP: D & A

ABANDONED

County Kingman State Kansas

Sec. 1 (Blk. Twp.) 30 (Sur. Rge.) 9W Map No.

Operator Rupp-Ferguson

Well No. 1 Farm Adelhart

Elev. 1551 Location NE SE NW

990 Ft. From S Line NW

330 Ft. From E Line Quarter

1st. Report

Completion APR 20 1955

Remarks Zenda Ext.

Co. tools

Spudding Date 4-1-55

Drig. Data D & A TD 4230

8" @ 273 Doug. 3303 Lans. 3465

Miss. 4177 DST 4179-85 open 2 hr.

Rec. 445' gas 24' gcm 31' gcmw

430# DST 4185-4206 open 1½ hr.

Rec. 57' gcm 62' sgcsw 730# TD 4230

D & A

ABANDONED

FABEN GILSTRAP