Kingman

KANSAS

SECTION 1 TOWNSHIP 30S RANGE 9W

WELL NO. #1 Shatell Unit

COMPANY Rupp-Ferguson

NORTH NW NE NE

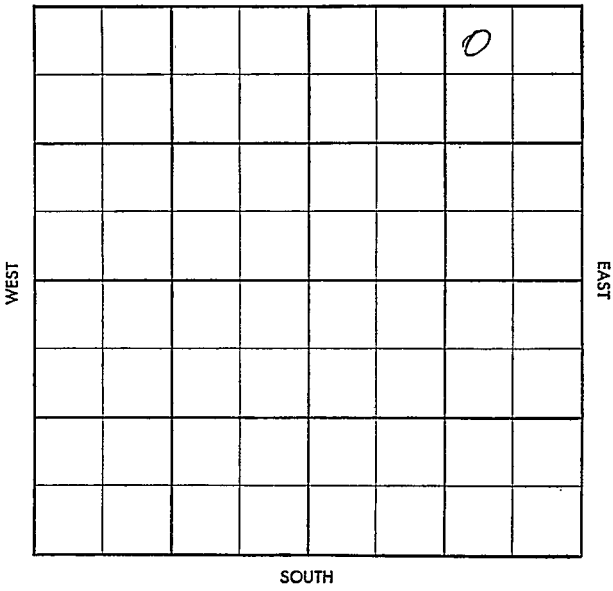

FORM 504-3 SUNRAY

Twp. X Pool X

Sec. X Farm

S-513-B

County Kingman Elev.

Sec. 1 Twp. 30 Rge. 9W

Company Rupp-Ferguson

Farm Name Shatell Unit No. 1

TOPS	DEPTH	LOG	DATUM
Anh.			
Tp.			
H.			
Tr.			
Dg.			
B.L.			
L.			
K.C.			
B.K.C.			
Ce.			
C.			
M.			
M.			
K.			
Mz.			
Mq.			
V.			
S.			
S.			
A.			
R.			
Pf.			
G.			
T.D.			

Loc. in Sec. NW NE NE

Geol.

Contr. Co. Tools

Pool Spivey-Grabs

RST REPORT

JUN 25 '58

Date Comm. 6-19-58

8" @ 251 w/175, Drlg. 3085.

Co. Lse. No. Sec. T. R.

Twp. X Pool X

Co. X Facet X

S-513-B

County Kingman Elev. 15, 2[illegible], 25[illegible]

Sec. 1 Twp. 30 Rge. 9W

Company Rupp-Ferguson

Farm Name Shatell Unit No. 1

TOPS	DEPTH	LOG	DATUM
Anh.			
Tp.			
H.	3251		
Tr.			
Dg.	3321		
B.L.			
L.	3465		
K.C.			
B.K.C.			
Ce.			
C.			
M.	4154		
M.			
K.			
Mz.			
Mq.			
V.			
S.			
S.			
A.			
R.			
Pf.			
G.			
T.D.	4215		

Loc. in Sec. NW LE NE

Geol.

Contr. Co. Tools

Pool Spivey-Grabs

ABANDONED
JUL 2 58

Date Comm. 6-19-58

8" @ 251 w/175, Drlg. 3085. JUL - 58 Sanlog

D&A

Co. Lse. No. Sec. T. R.