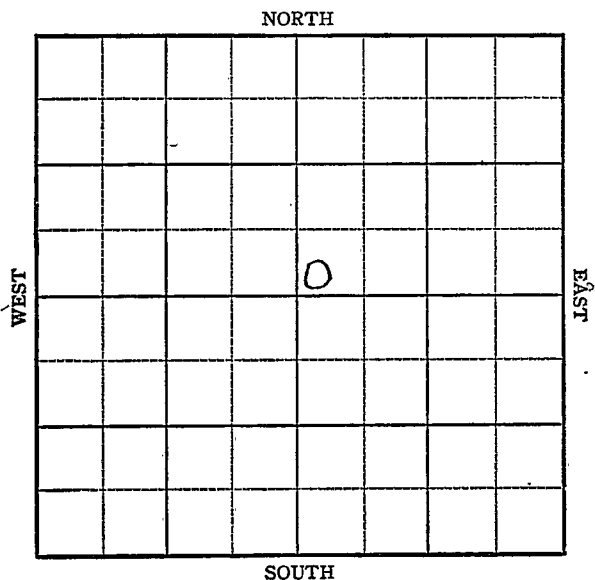


KANSAS

Haskell

Section 1 Township 30 Range 34WWell No. 1 MoodyCompany United Prod.

Sec. 1 Twp. 30 R. 34-W

Well No. #1 Moody Farm
United ^Prod Company


Hugoton

 Ft. from N. Line

100 Ft. from S. Line

 Ft. from E. Line

100 Ft. from W. Line

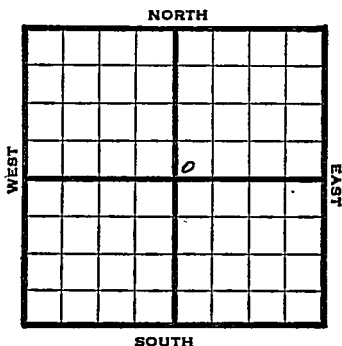

SW NE

Elev. 2975' REPORT

1948

8/11

Location

8/18

Drlg 518'

8/25

10" @ 656'

TD 2611'

7" @ 2609'

9/1

Drlg. 2738'

9/8

TD 2770'

9/14

14,000 acid

9/21

"

9/29

"

10/6

7" @ 2609'

14000 acid

180' of 5" Perf liner @ 2770'

Acid 14,000

Gas 15,700,000

R. Pr. 407#

TD 2770'

COMPLETED

Haskell County Kansas State

Map No. _____ Sec. 1 Twp. 30 R. 34W

Well No. 1 Moody

United Prod. Company

FIRST REPORT Contractor

SW NE

SECTION PLAT

 Ft. from N. Line

100 Ft. from S. Line

 Ft. from E. Line

100 Ft. from W. Line

Hugoton Pool

Remarks:

Location

Date

AUG 11 1948

Scout

S. J. LEWIS

Map No. _____ Sec. 1 Twp. 30 R. 34W

Well No. 1 Moody

United Prod. _____ Company

COMPLETE

Contractor

SW NE


E1.2975
SECTION PLAT

_____ Ft. from N. Line

100 Ft. from S. Line

_____ Ft. from E. Line

100 Ft. from W. Line

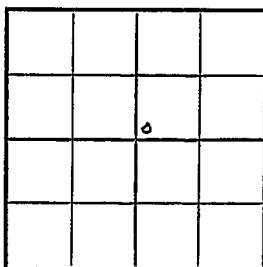

Haskell County

Location _____

Rig up _____

Drilling and Remarks:

7" @ 2609

14000 acid

180' by 5" Perforated

@ 2770

14000 acid

15,700,000 Gall

*402 * R 1/2*

RECORD

Cased _____ in., _____ ft.

Sand _____

Gas _____

Oil _____

Total Depth 2770

PRODUCTION

1st 24 hrs. Nat. _____

1st 24 hrs. after shot _____

Gas _____ Cu. Ft.

Dry Hole _____

Abandoned _____

Date

OCT 6 1948

19

S. J. LEWIS Scout