


DX 78-1

Haskell KANSAS

Section 1 Township 30 Range 32W

Well No. 1 Huxman

Company William Graham

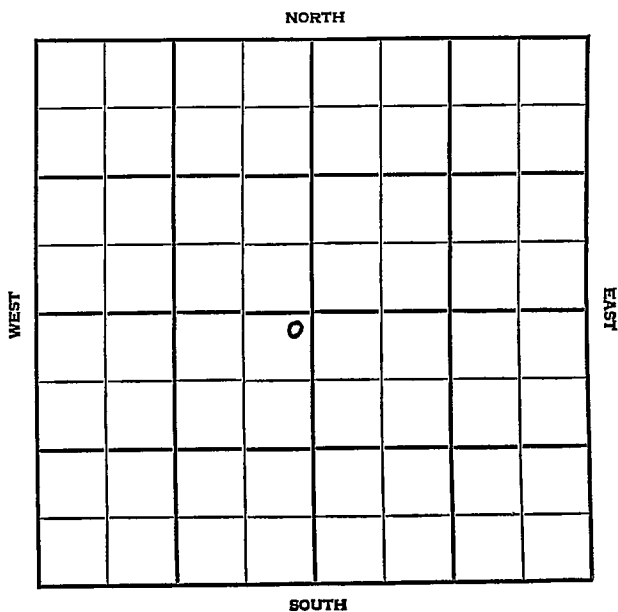

# Haskell

**KANSAS**

|                  |                   |                  |
|------------------|-------------------|------------------|
| SEC.<br><b>1</b> | TWP.<br><b>30</b> | R.<br><b>32W</b> |
|------------------|-------------------|------------------|

WELL NO. **#1 Huxman** FARM

COMPANY **William Graham**

CONTRACTOR **Co. Tools.**


## Hugoton Pool

100 Ft. from N. Line

\_\_\_\_\_ Ft. from S. Line

100 Ft. from E. Line

\_\_\_\_\_ Ft. from W. Line

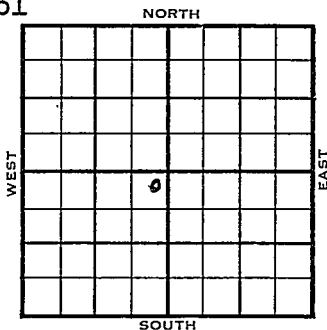

NE NE SW

CSO - F/O

|      |                           |        |
|------|---------------------------|--------|
| 1954 | ELEVATION<br><b>2875'</b> | REPORT |
|------|---------------------------|--------|

11/3 Spud 10-30-54  
8" @ 534'  
Drlg. 1925'

12/15 Spud 10-30-54 D & A TD 2735  
8" @ 534' Her. 2676 Kri. 2712  
TD 2735 5" @ 2734 CO to 2730  
64/2712-28 56/2676-90 1000 A  
frac. CO to 2722 20/2710-20  
500 A 100,000 CFG 8 GWPB SP 2700  
20/2680-90 CO to 2722 2000 A wtr.  
CO to 2693 48/2678-90 3500 A  
D & A

**ABANDONED**



